FILED
RECEIVED

JUN 30 1972

COUNTY SURVEYOR
DOUGLAS COUNTY, ORE.

COUNTY SURVEYORS FILE DATA
DO NOT REMOVE FROM OFFICE

AGREEMENT LINE SURVEY
IN SEC. 1, T. 29S., R. 5 W. W. M.
FOR VILLAGE REALTY
by BRUCE ROGERS
JUNE, 1972
1" = 100'

REGISTERED
OREGON
LAND SURVEYOR
Bruce L. Rogers
BRUCE M. ROGERS
660

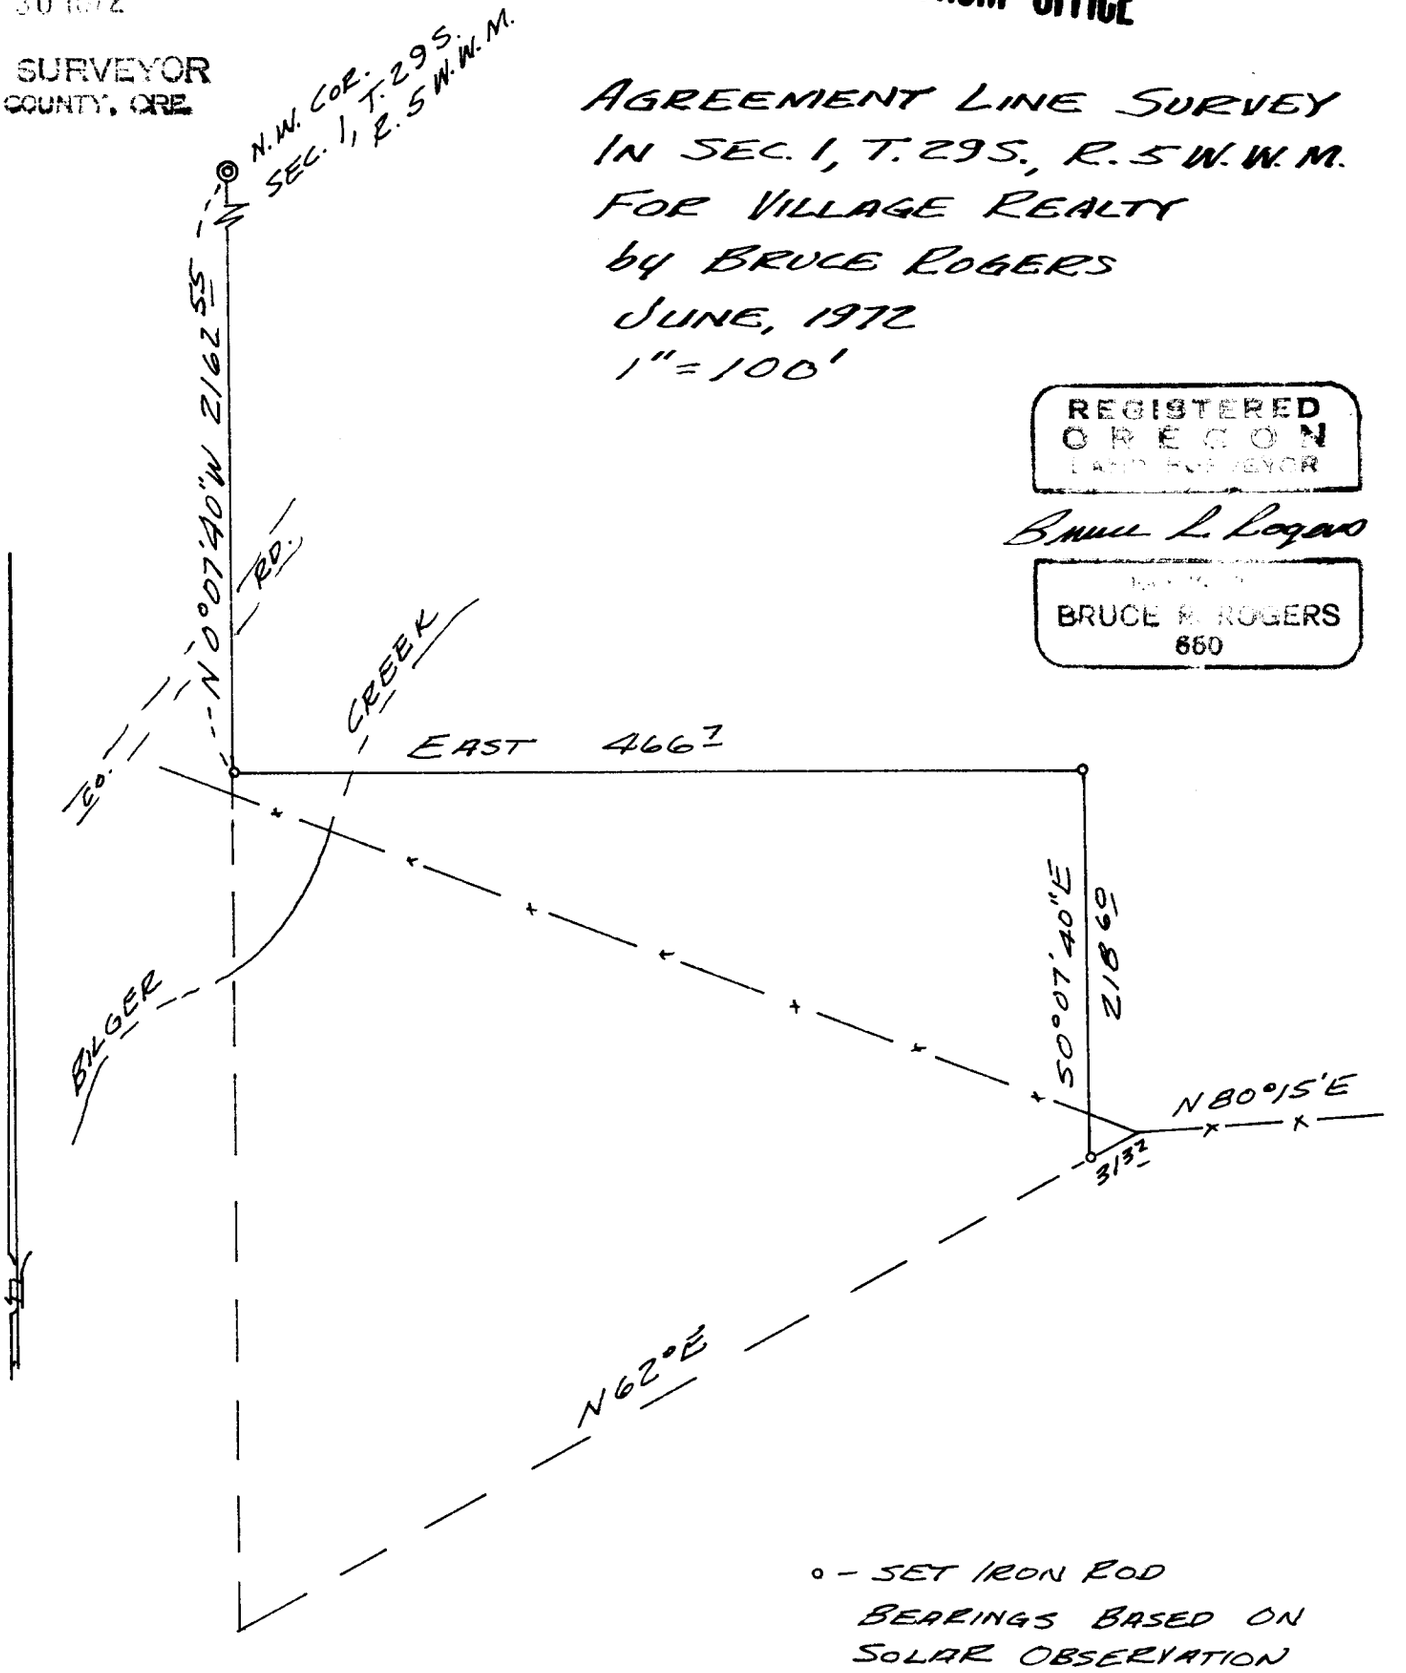

o - SET IRON ROD
BEARINGS BASED ON
SOLAR OBSERVATION

C. S. File No. 55/258-1