FIELD SURVEY & PLAT FOR
BLUE DIAMOND REALTY
IN SECTION 16, T. 27S., R6 W.W.M.
by BRUCE ROGERS
APRIL 24, 1973
1" = 100'

COUNTY SURVEYORS FILE DATA
DO NOT REMOVE FROM OFFICE

FILED
RECEIVED
APR 23 1973
COUNTY SURVEYOR
DOUGLAS COUNTY, ORE.

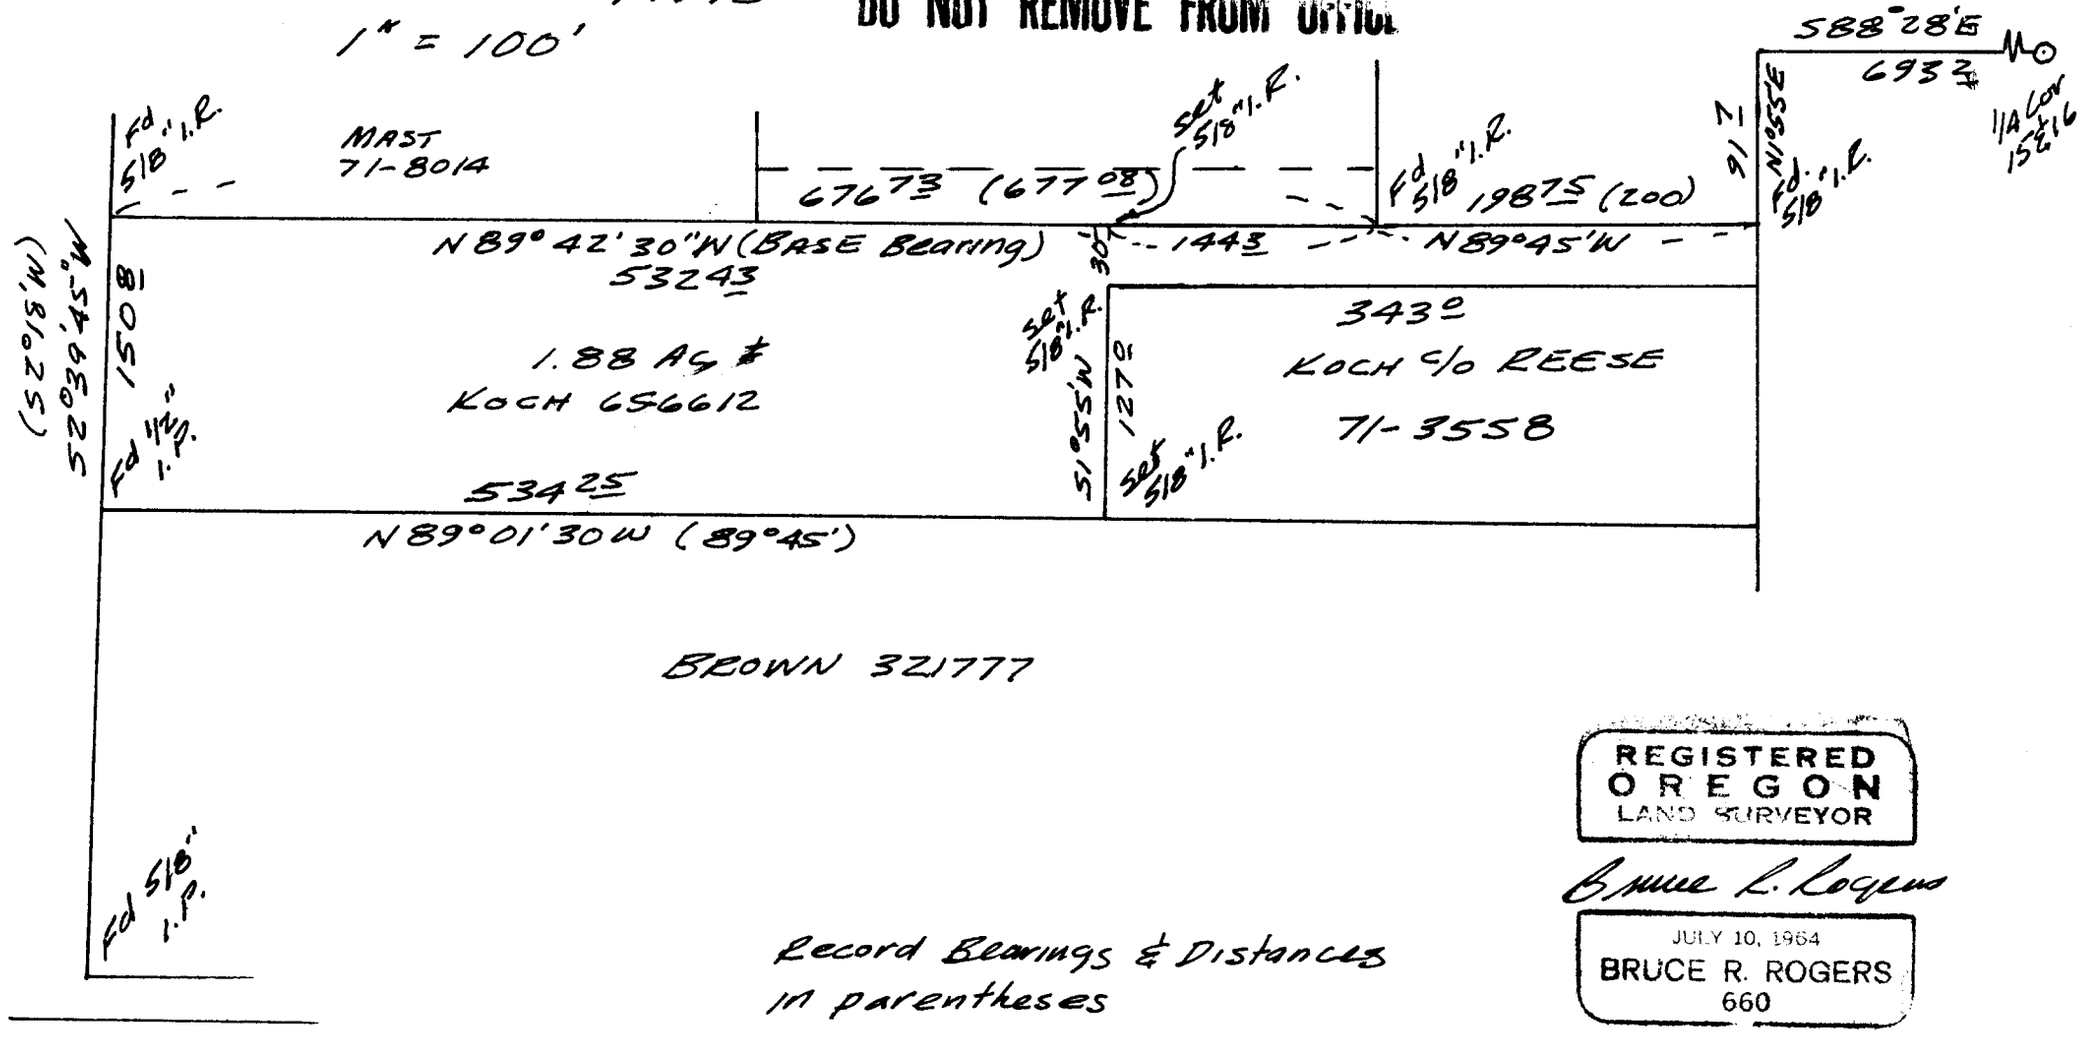

Record Bearings & Distances in parentheses

REGISTERED
OREGON
LAND SURVEYOR
Bruce R. Rogers
JULY 10, 1964
BRUCE R. ROGERS
660

C.S. File No. 55/277-3