SURVEY IN SECTION 2, T.29S., R.6W., W.M.

Surveyed for — BILL SHEA

Surveyed by — DON E. GARRETT

March 1973

Scale 1" = 100'

COUNTY SURVEYORS FILE DATA
DO NOT REMOVE FROM OFFICE

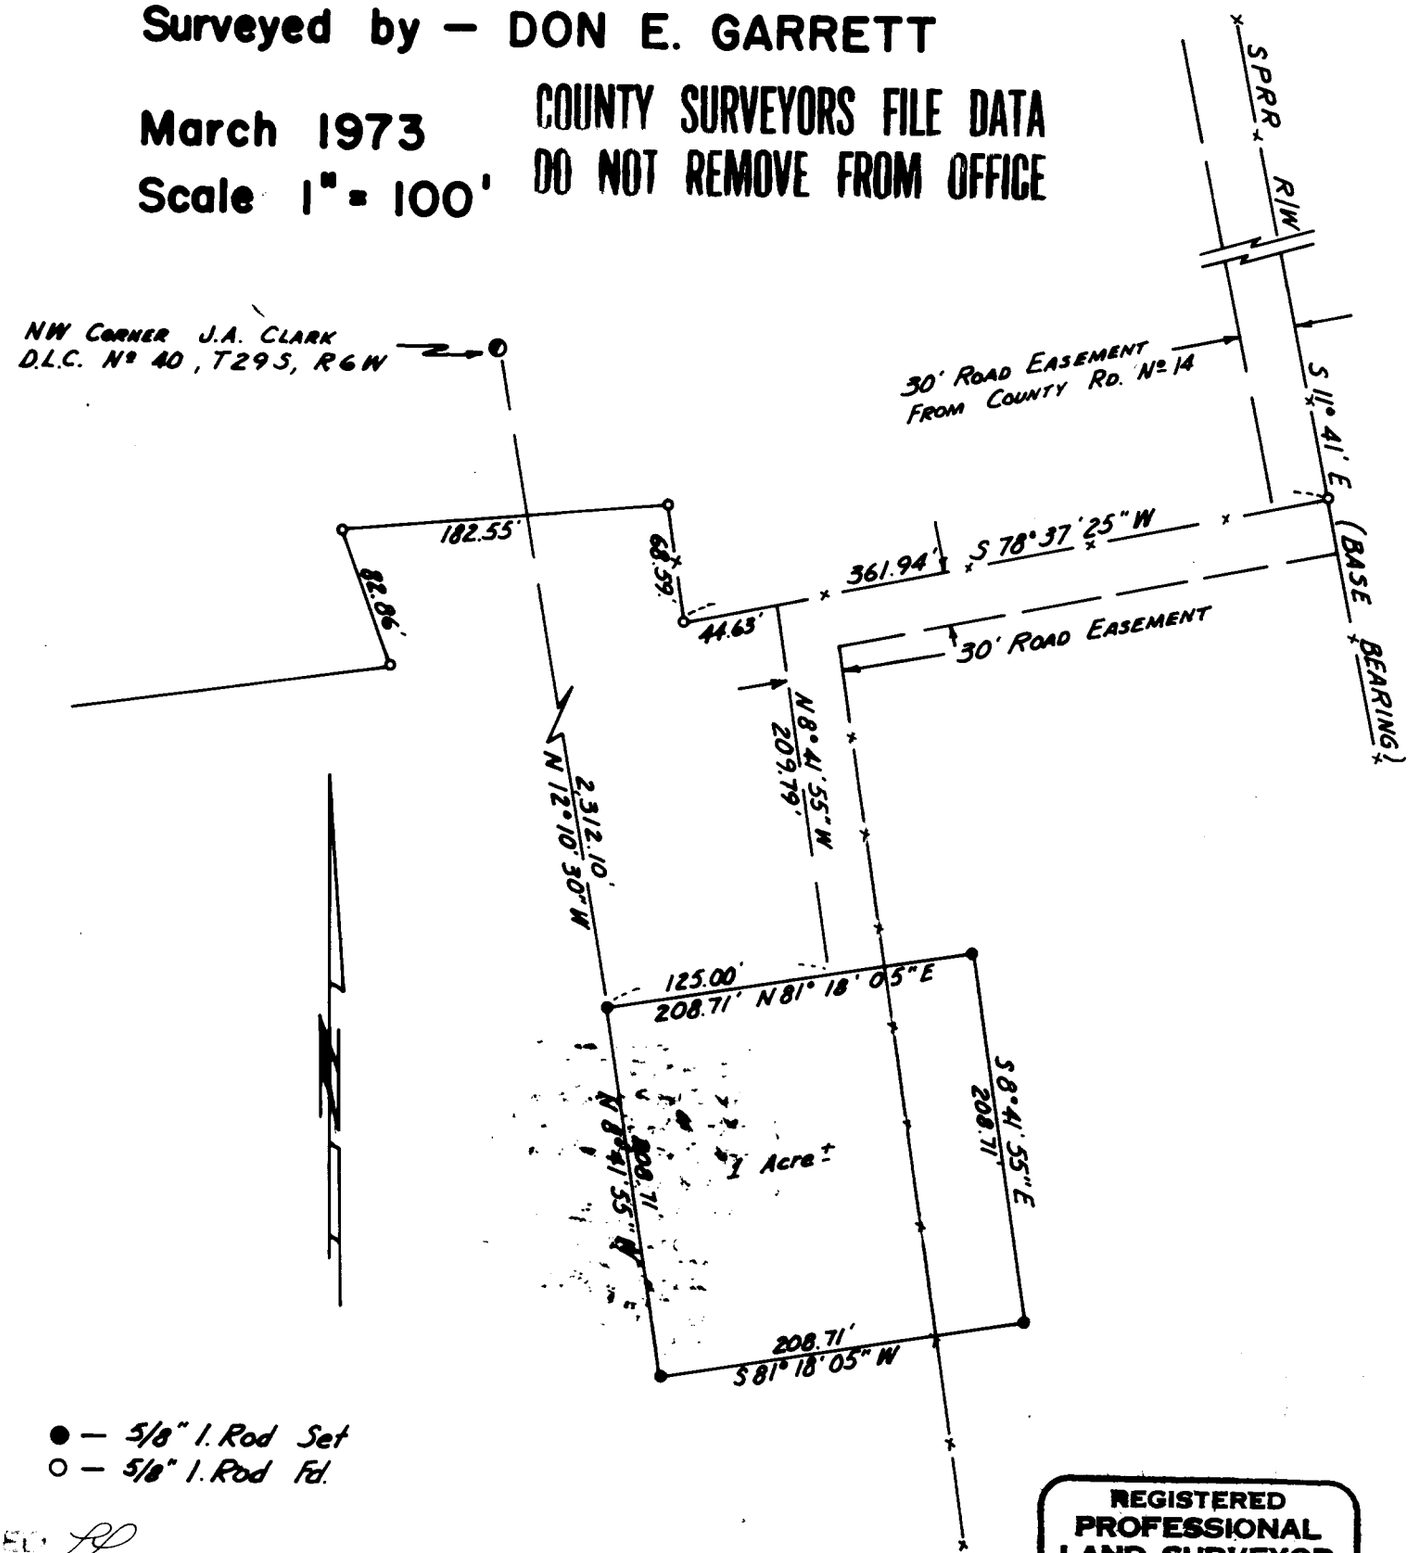

● — 5/8" I. Rod Set
○ — 5/8" I. Rod Fd.

FILED
REC
3 1973
COUNTY SURVEYOR
DOUGLAS COUNTY, ORE.

REGISTERED
PROFESSIONAL
LAND SURVEYOR
Don E. Garrett
OREGON
JULY 14, 1961
DON E. GARRETT
844

C. S. File No. 55/278-3