SURVEY FOR DEED DESCRIPTION
IN LOTS 7, 8, 9 & 10, BLOCK 1, PLAT I,
SUTHERLIN LAND & WATER CO. IN SEC. 13, T. 25S. R 5W
SURVEYED FOR KNIGHT REALTY
by BRUCE ROGERS
MAY, 1973
1" = 200'

COUNTY SURVEYORS FILE DATA
DO NOT REMOVE FROM OFFICE

FILED
RECEIVED
JUN 5 1973
COUNTY SURVEYOR
DOUGLAS COUNTY, ORE.

REGISTERED
OREGON
LAND SURVEYOR
Bruce L. Rogers
JULY 10, 1964
BRUCE R. ROGERS
660

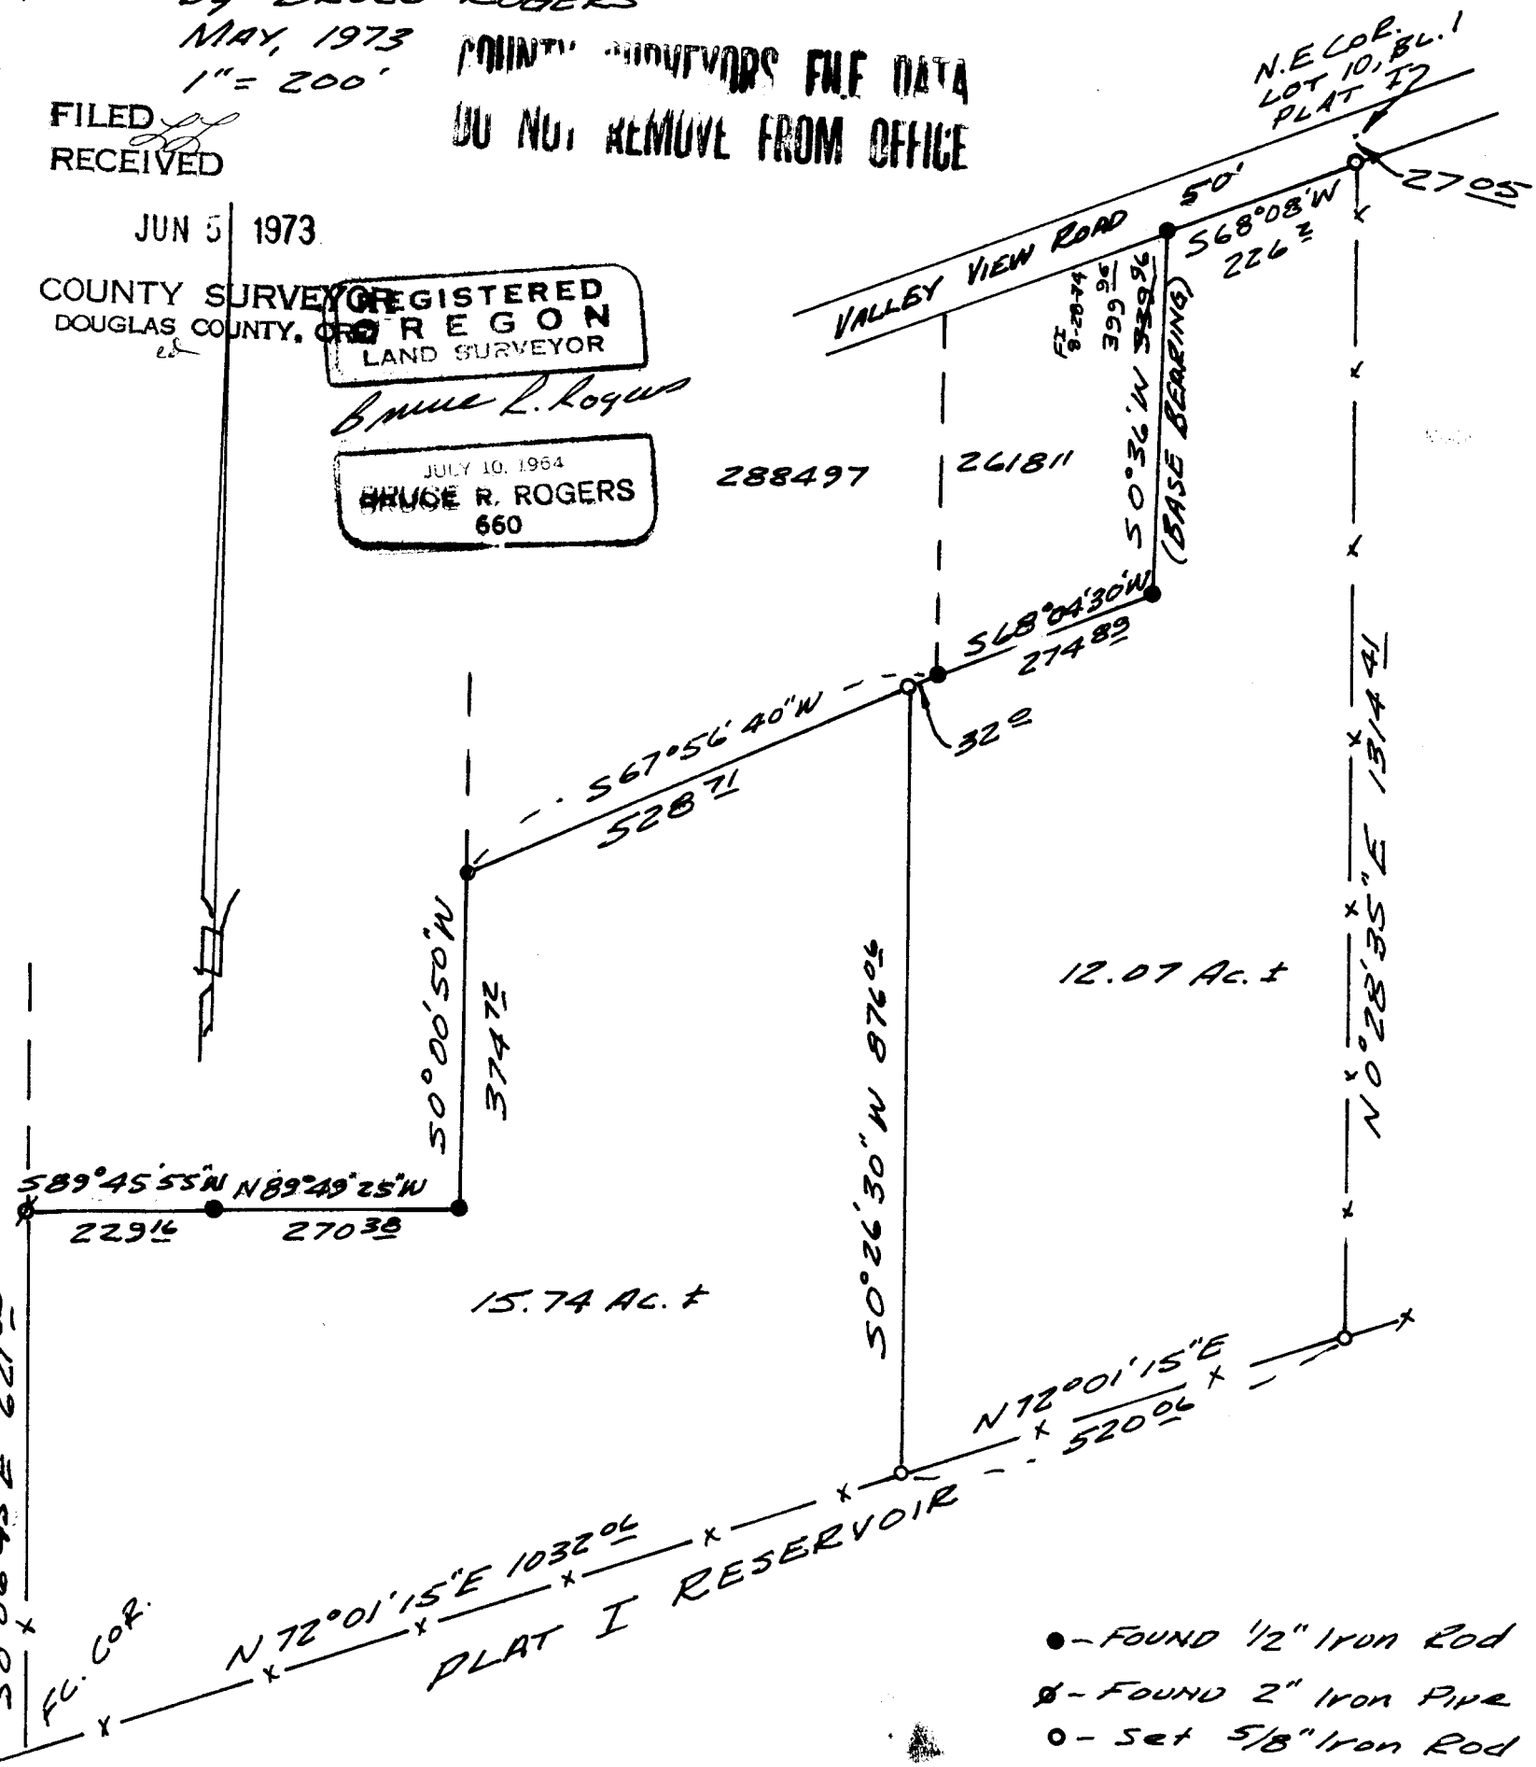

● - FOUND 1/2" Iron Rod
Ø - FOUND 2" Iron Pipe
○ - Set 5/8" Iron Rod

C.S. File No. 55/289-2