Survey for WILLIAM KUZELL

Located in Sec. 27 - D.L.C. #47 - T. 26 S., R. 6 W., W.M

Scale: 1" = 50'

COUNTY SURVEYORS FILE DATA
DO NOT REMOVE FROM OFFICE

MAY 24, 1973
FILED
RECEIVED

MAY 25 1973
COUNTY SURVEYOR
DOUGLAS COUNTY, ORE.

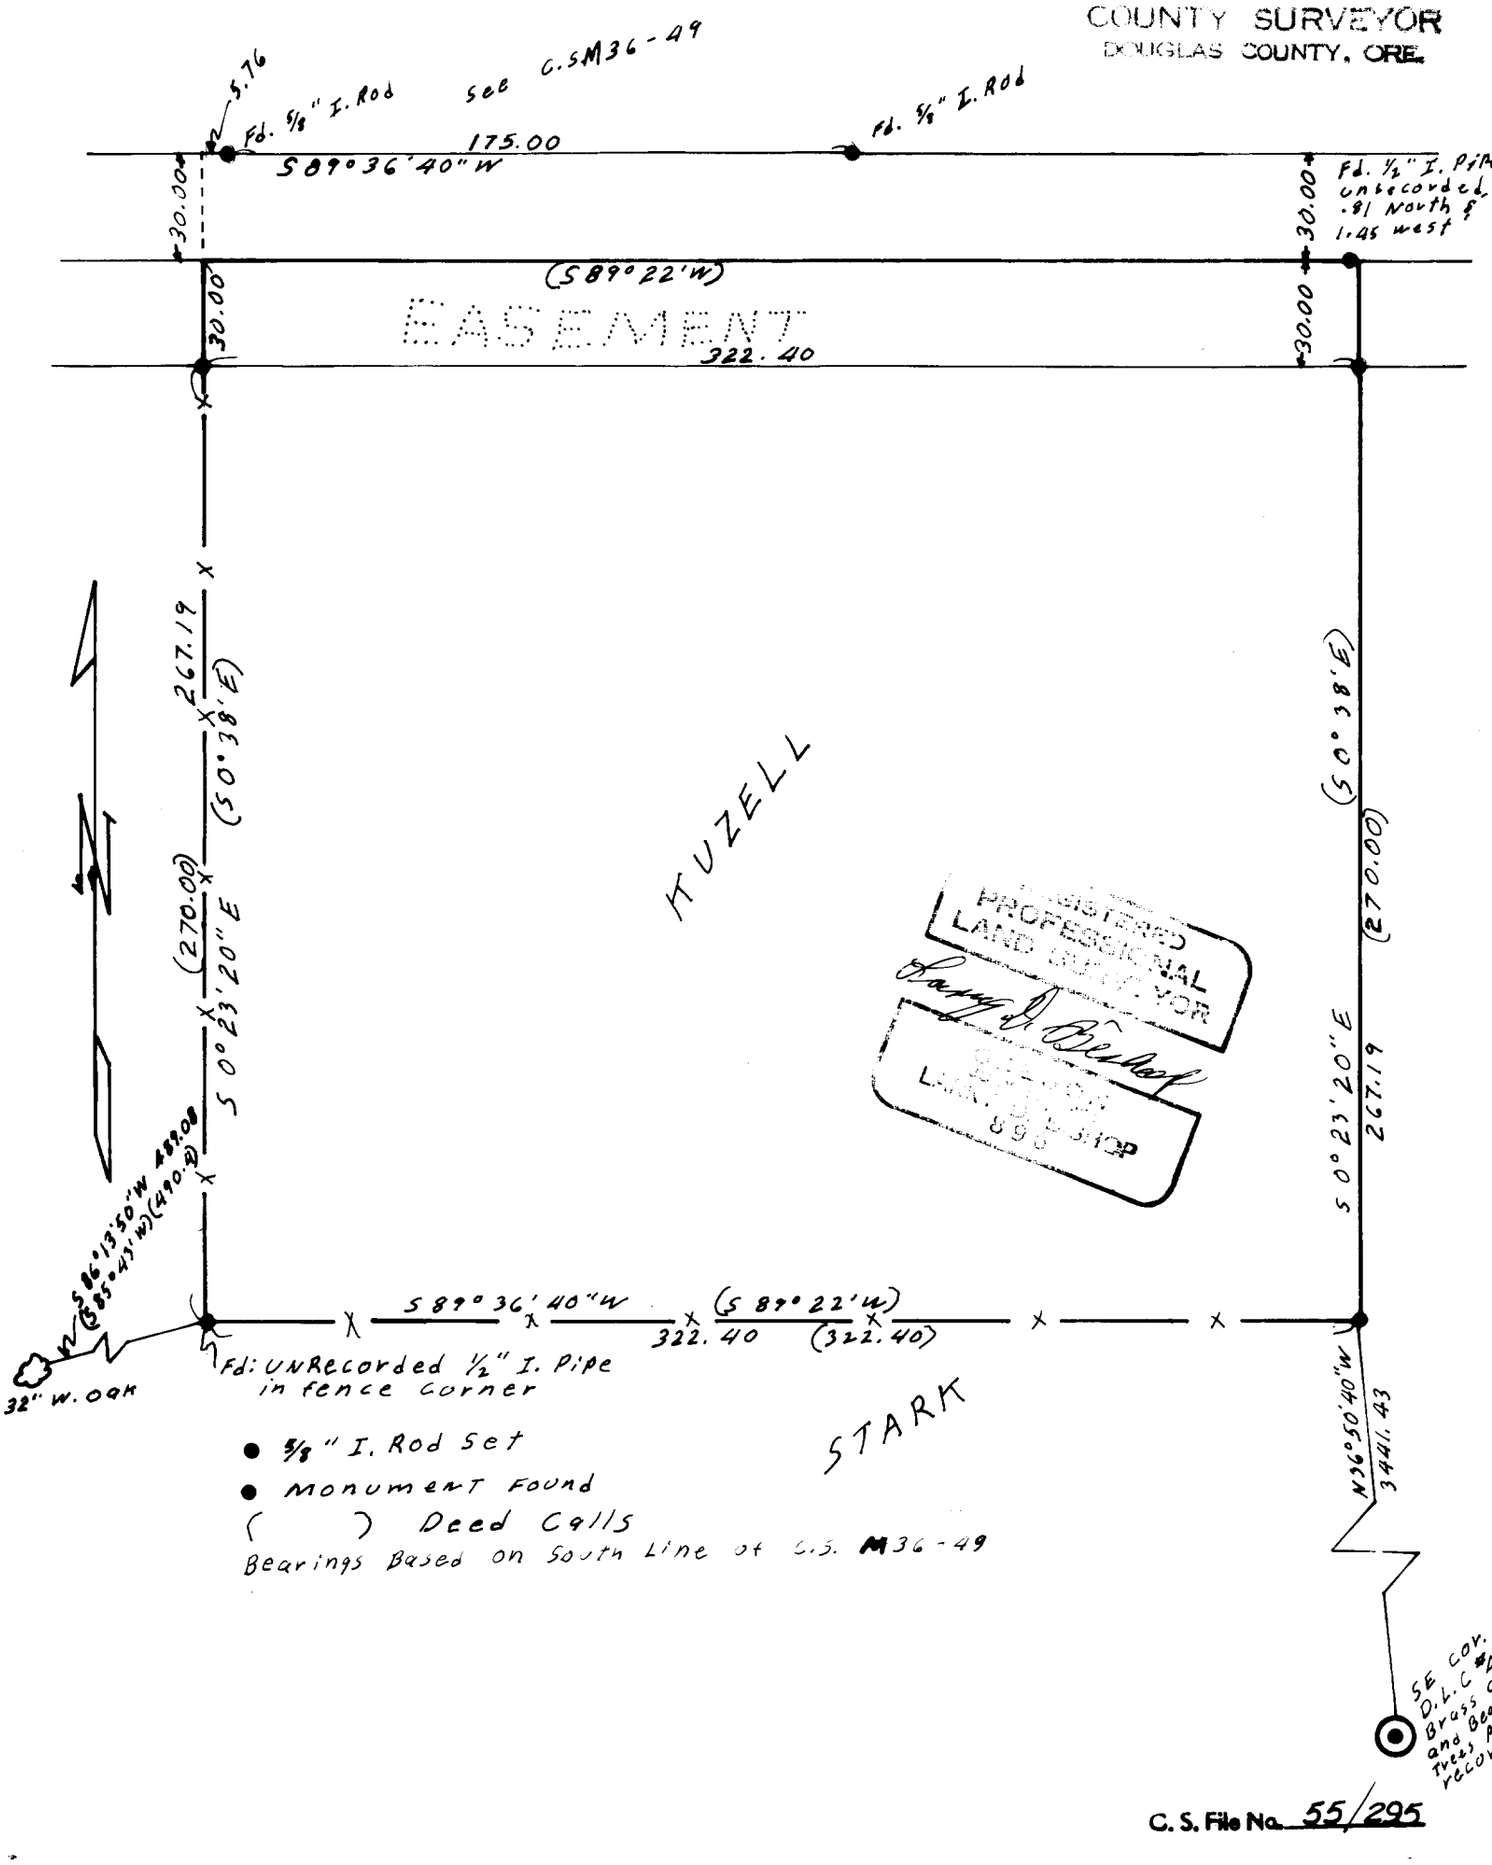

● 5/8" I. Rod Set
● Monument Found
( ) Deed Calls
Bearings Based on South Line of C.S. M36-49

C. S. File No. 55/295