FROM BATTRUM

LOT 12 · RIO VERDE · DOUGLAS COUNTY · OREGON

COUNTY SURVEYORS FILE DATA
DO NOT REMOVE FROM OFFICE

Leslie L. Bartrum.

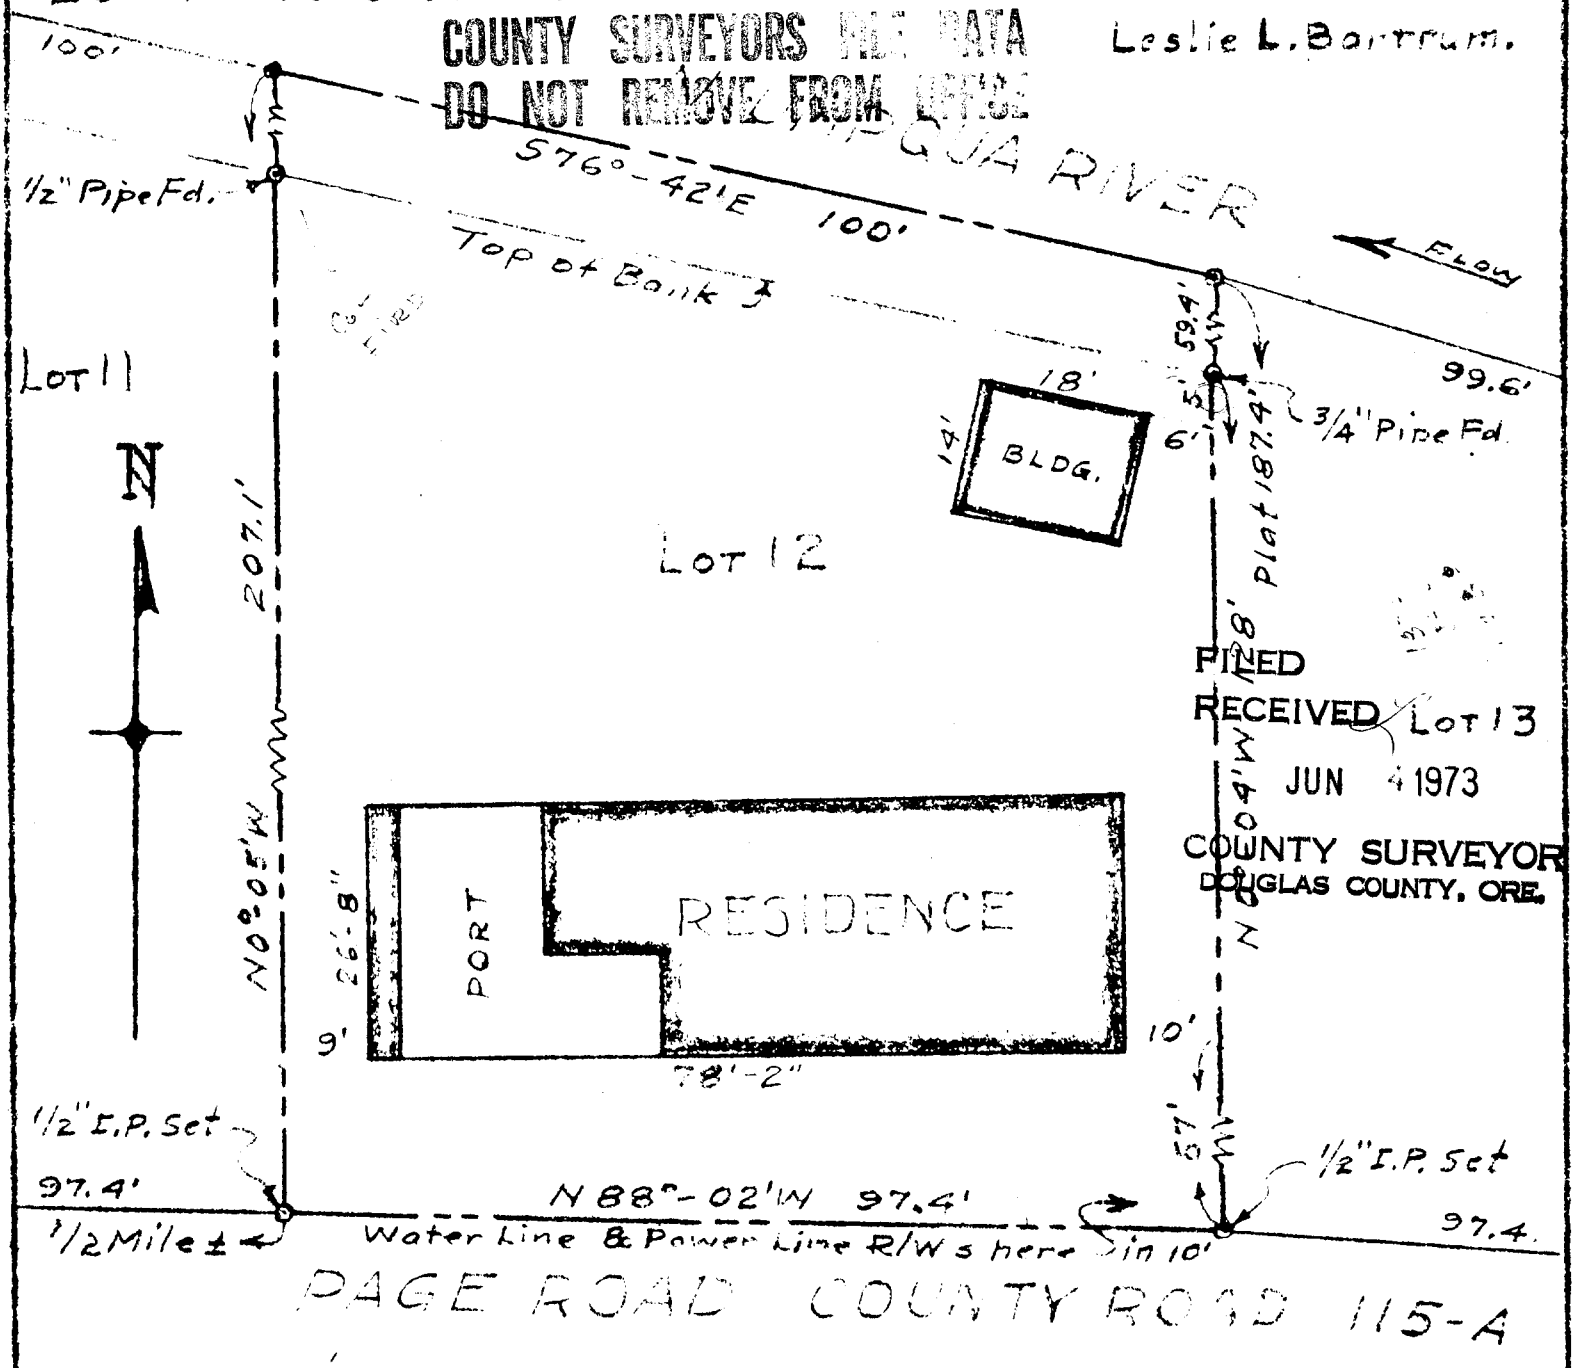

FILED
RECEIVED
JUN 4 1973
COUNTY SURVEYOR
DOUGLAS COUNTY, ORE.

I, James R. Daugherty, hereby certify that I have surveyed the Lot shown on the above MAP and found the RESIDENCE thereon to be located completely within the Property Lines shown.

SCALE 1" = 20'

JAMES R. DAUGHERTY
CIVIL-SANITARY ENGINEER
ROSEBURG · ORE.

James R. Daugherty

C.S File 55/298

June 30. 1956.

RUSSELL

Map File M 48-65