COUNTY SURVEYORS FILE DATA
DO NOT REMOVE FROM OFFICE

SURVEY FOR DEED DESCRIPTION
IN SEC. 9, T. 25S., R. 4 W.W.M.
FOR OSCAR BRANDNER
by BRUCE ROGERS
JUNE, 1973
1" = 100'

FILED
RECEIVED
JUN 25 1973
COUNTY SURVEYOR
DOUGLAS COUNTY, ORE.
ed
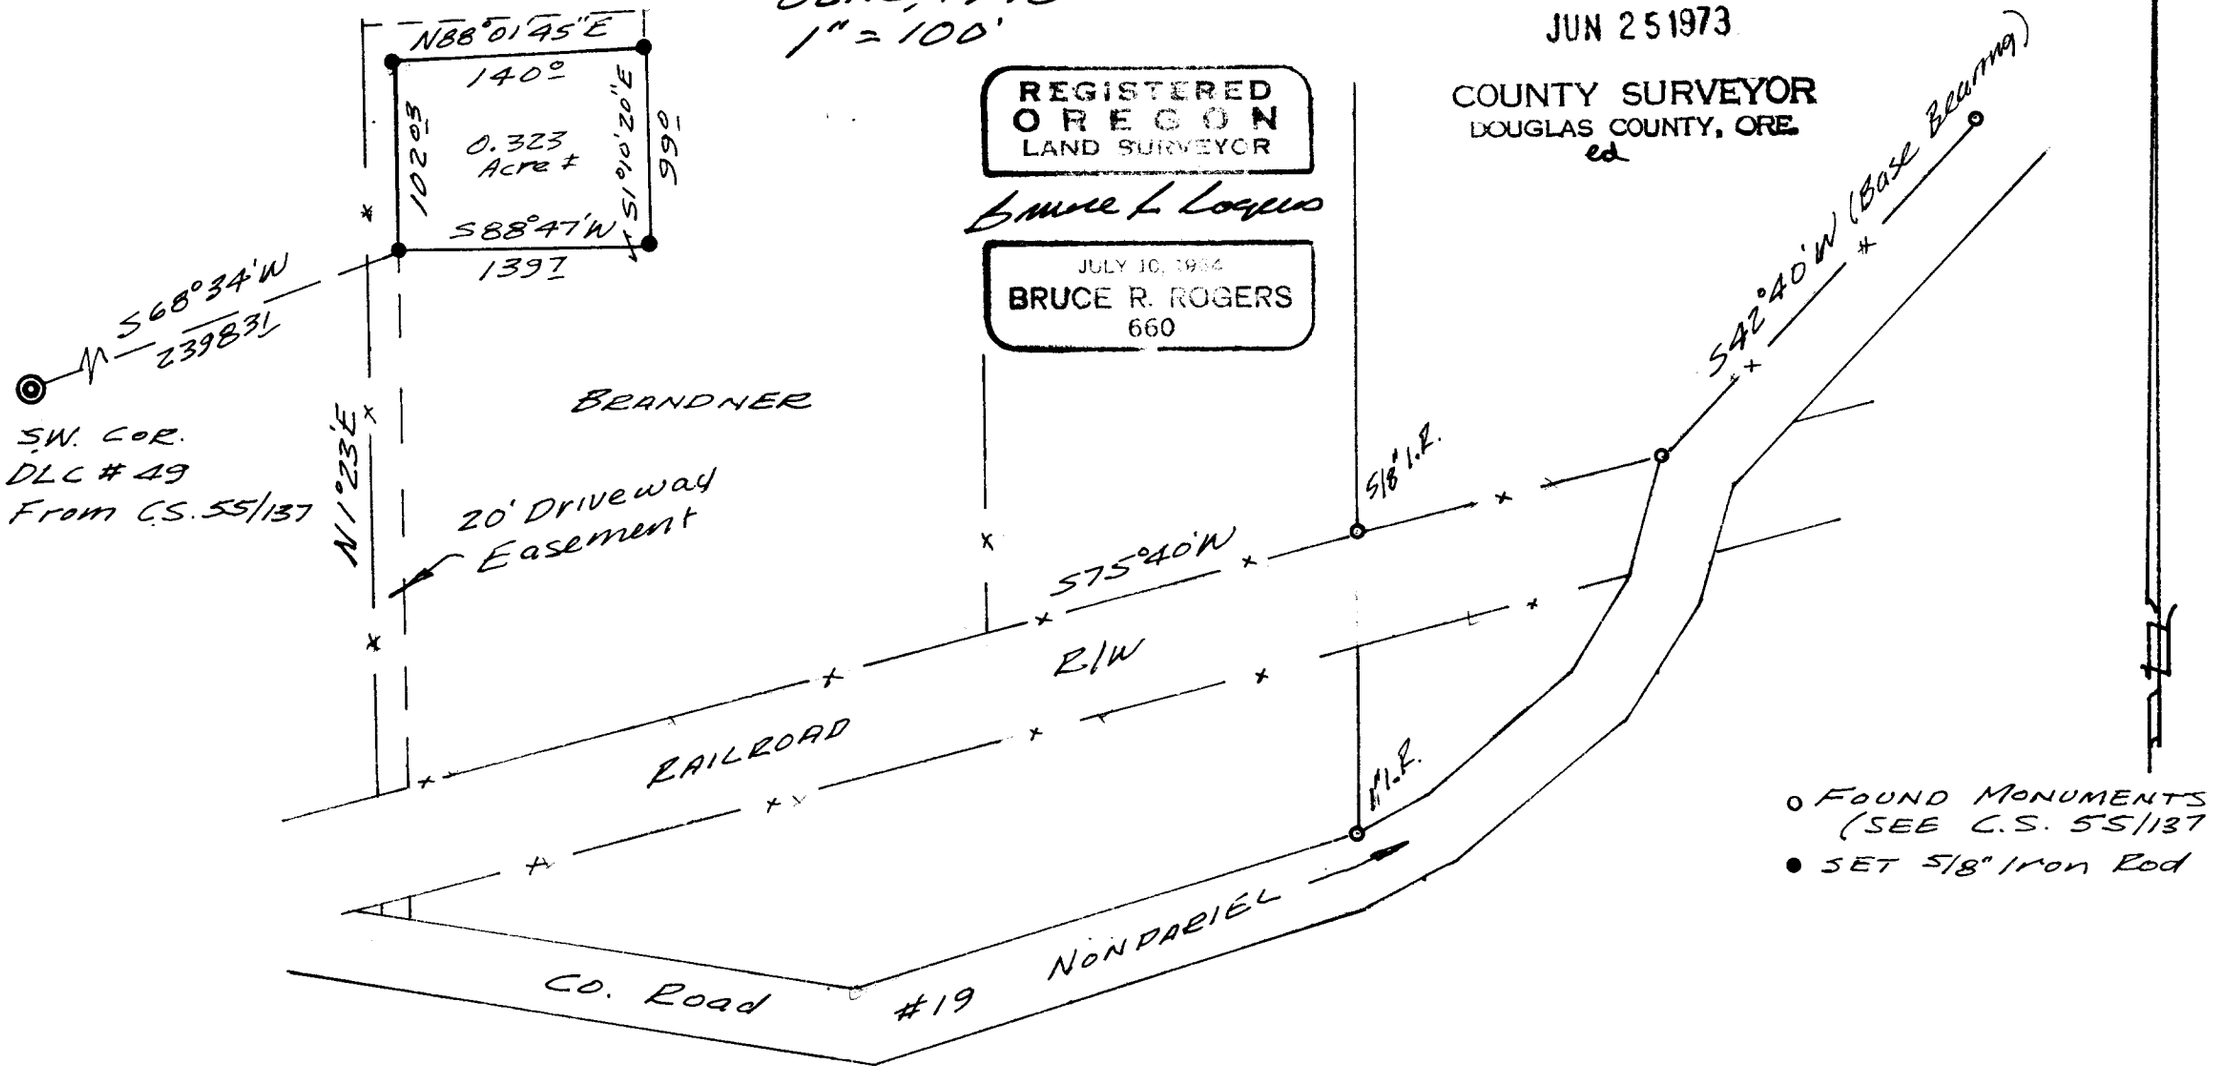
REGISTERED
OREGON
LAND SURVEYOR
Bruce L. Rogers
JULY 10, 1984
BRUCE R. ROGERS
660