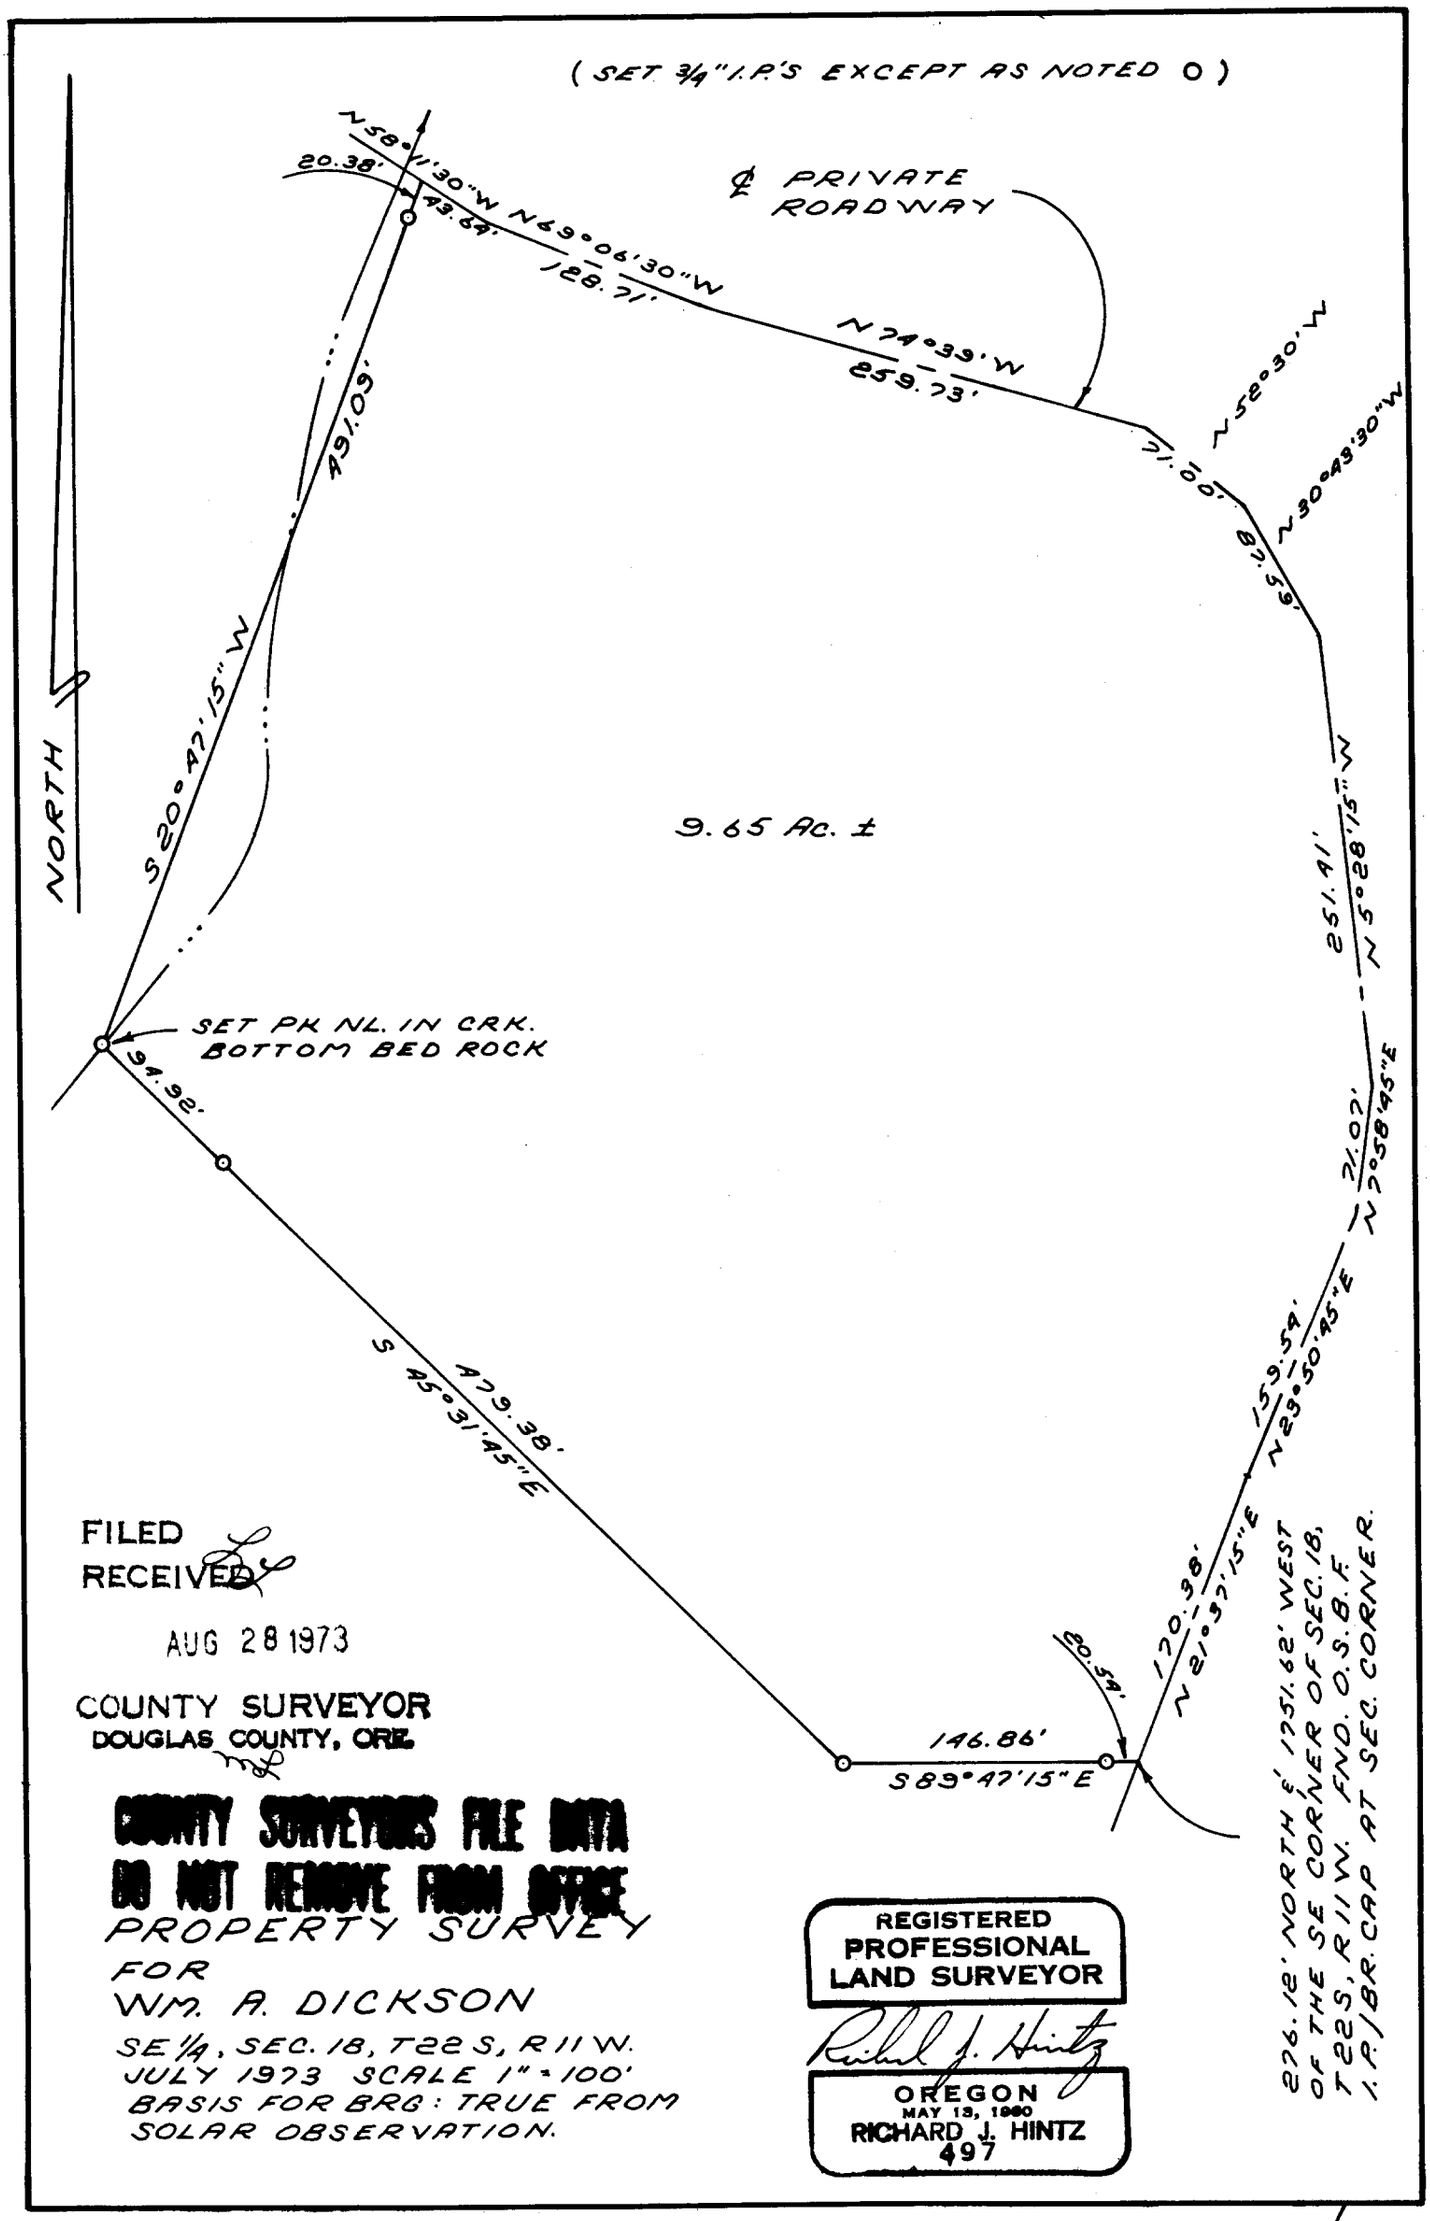

FILED
RECEIVED

AUG 28 1973

COUNTY SURVEYOR
DOUGLAS COUNTY, ORE.

COUNTY SURVEYOR'S FILE DATA
DO NOT REMOVE FROM OFFICE

PROPERTY SURVEY
FOR
WM. A. DICKSON
SE 1/4, SEC. 18, T22 S, R11 W.
JULY 1973 SCALE 1" = 100'
BASIS FOR BRG: TRUE FROM SOLAR OBSERVATION.

REGISTERED
PROFESSIONAL
LAND SURVEYOR

Richard J. Hintz

OREGON
MAY 13, 1960
RICHARD J. HINTZ
497

C. S. File No. 55/310-L