SURVEY TO SET PROPERTY CORNERS
IN SECTION 17, T. 32 S., R. 4 W. W.M.
FOR HAYWARD REED
by BRUCE ROGERS
AUG., 1973
1" = 100'

COUNTY SURVEYORS FILE DATA
DO NOT REMOVE FROM OFFICE

FILED
RECEIVED 2/7
AUG 28 1973
COUNTY SURVEYOR
DOUGLAS COUNTY, ORE.

REGISTERED
OREGON
LAND SURVEYOR
Bruce R. Rogers
JULY 10, 1964
BRUCE R. ROGERS
660

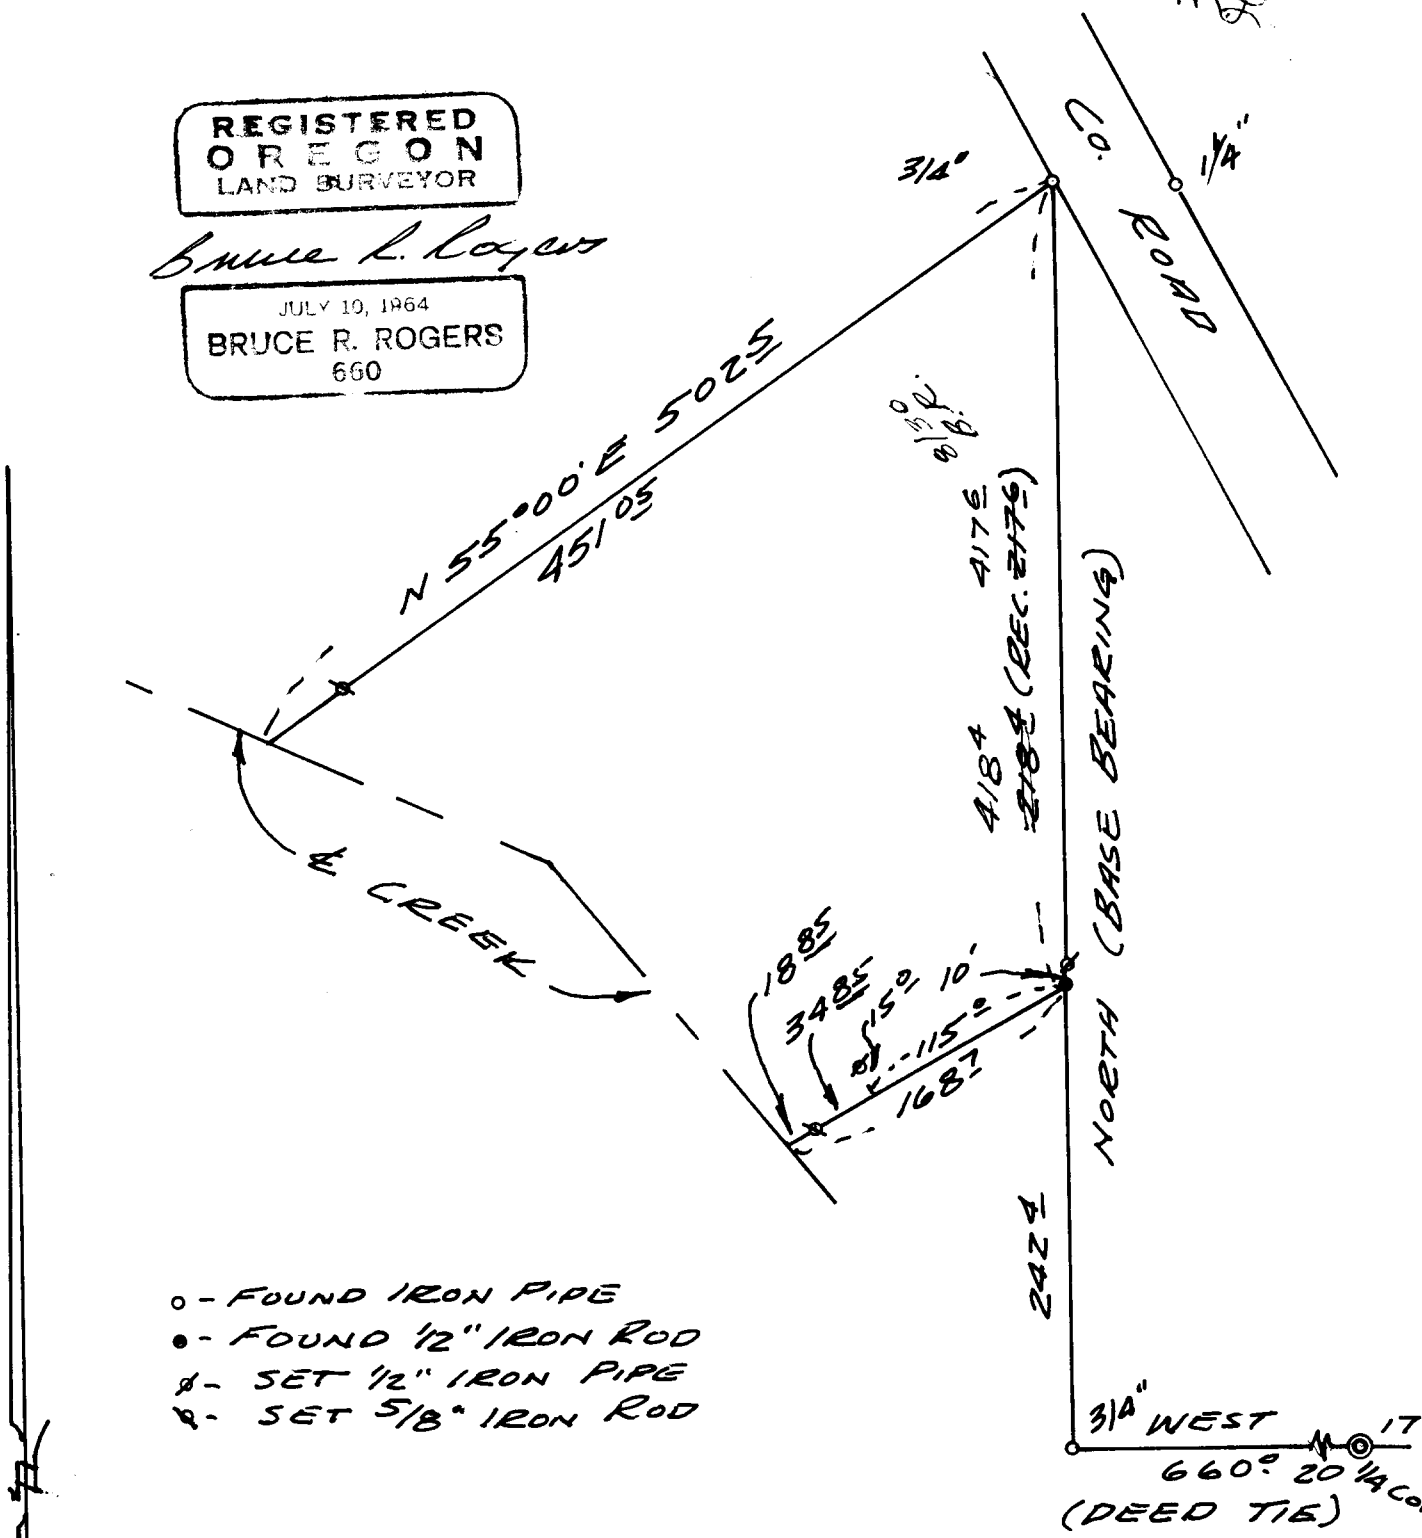

o - FOUND IRON PIPE
● - FOUND 1/2" IRON ROD
ø - SET 1/2" IRON PIPE
ø - SET 5/8" IRON ROD

C. S. File No. 55/311-1