


15-2-120
E16/55 S.7

COUNTY SURVEYORS FILE DATA
DO NOT REMOVE FROM OFFICE

SURVEY IN SEC. 15, 16, 21 & 22, T23S, R5W, W/M
Surveyed for Dan Webb by Don Garrett & Don Bentz
June 1973
Scale 1" = 200'

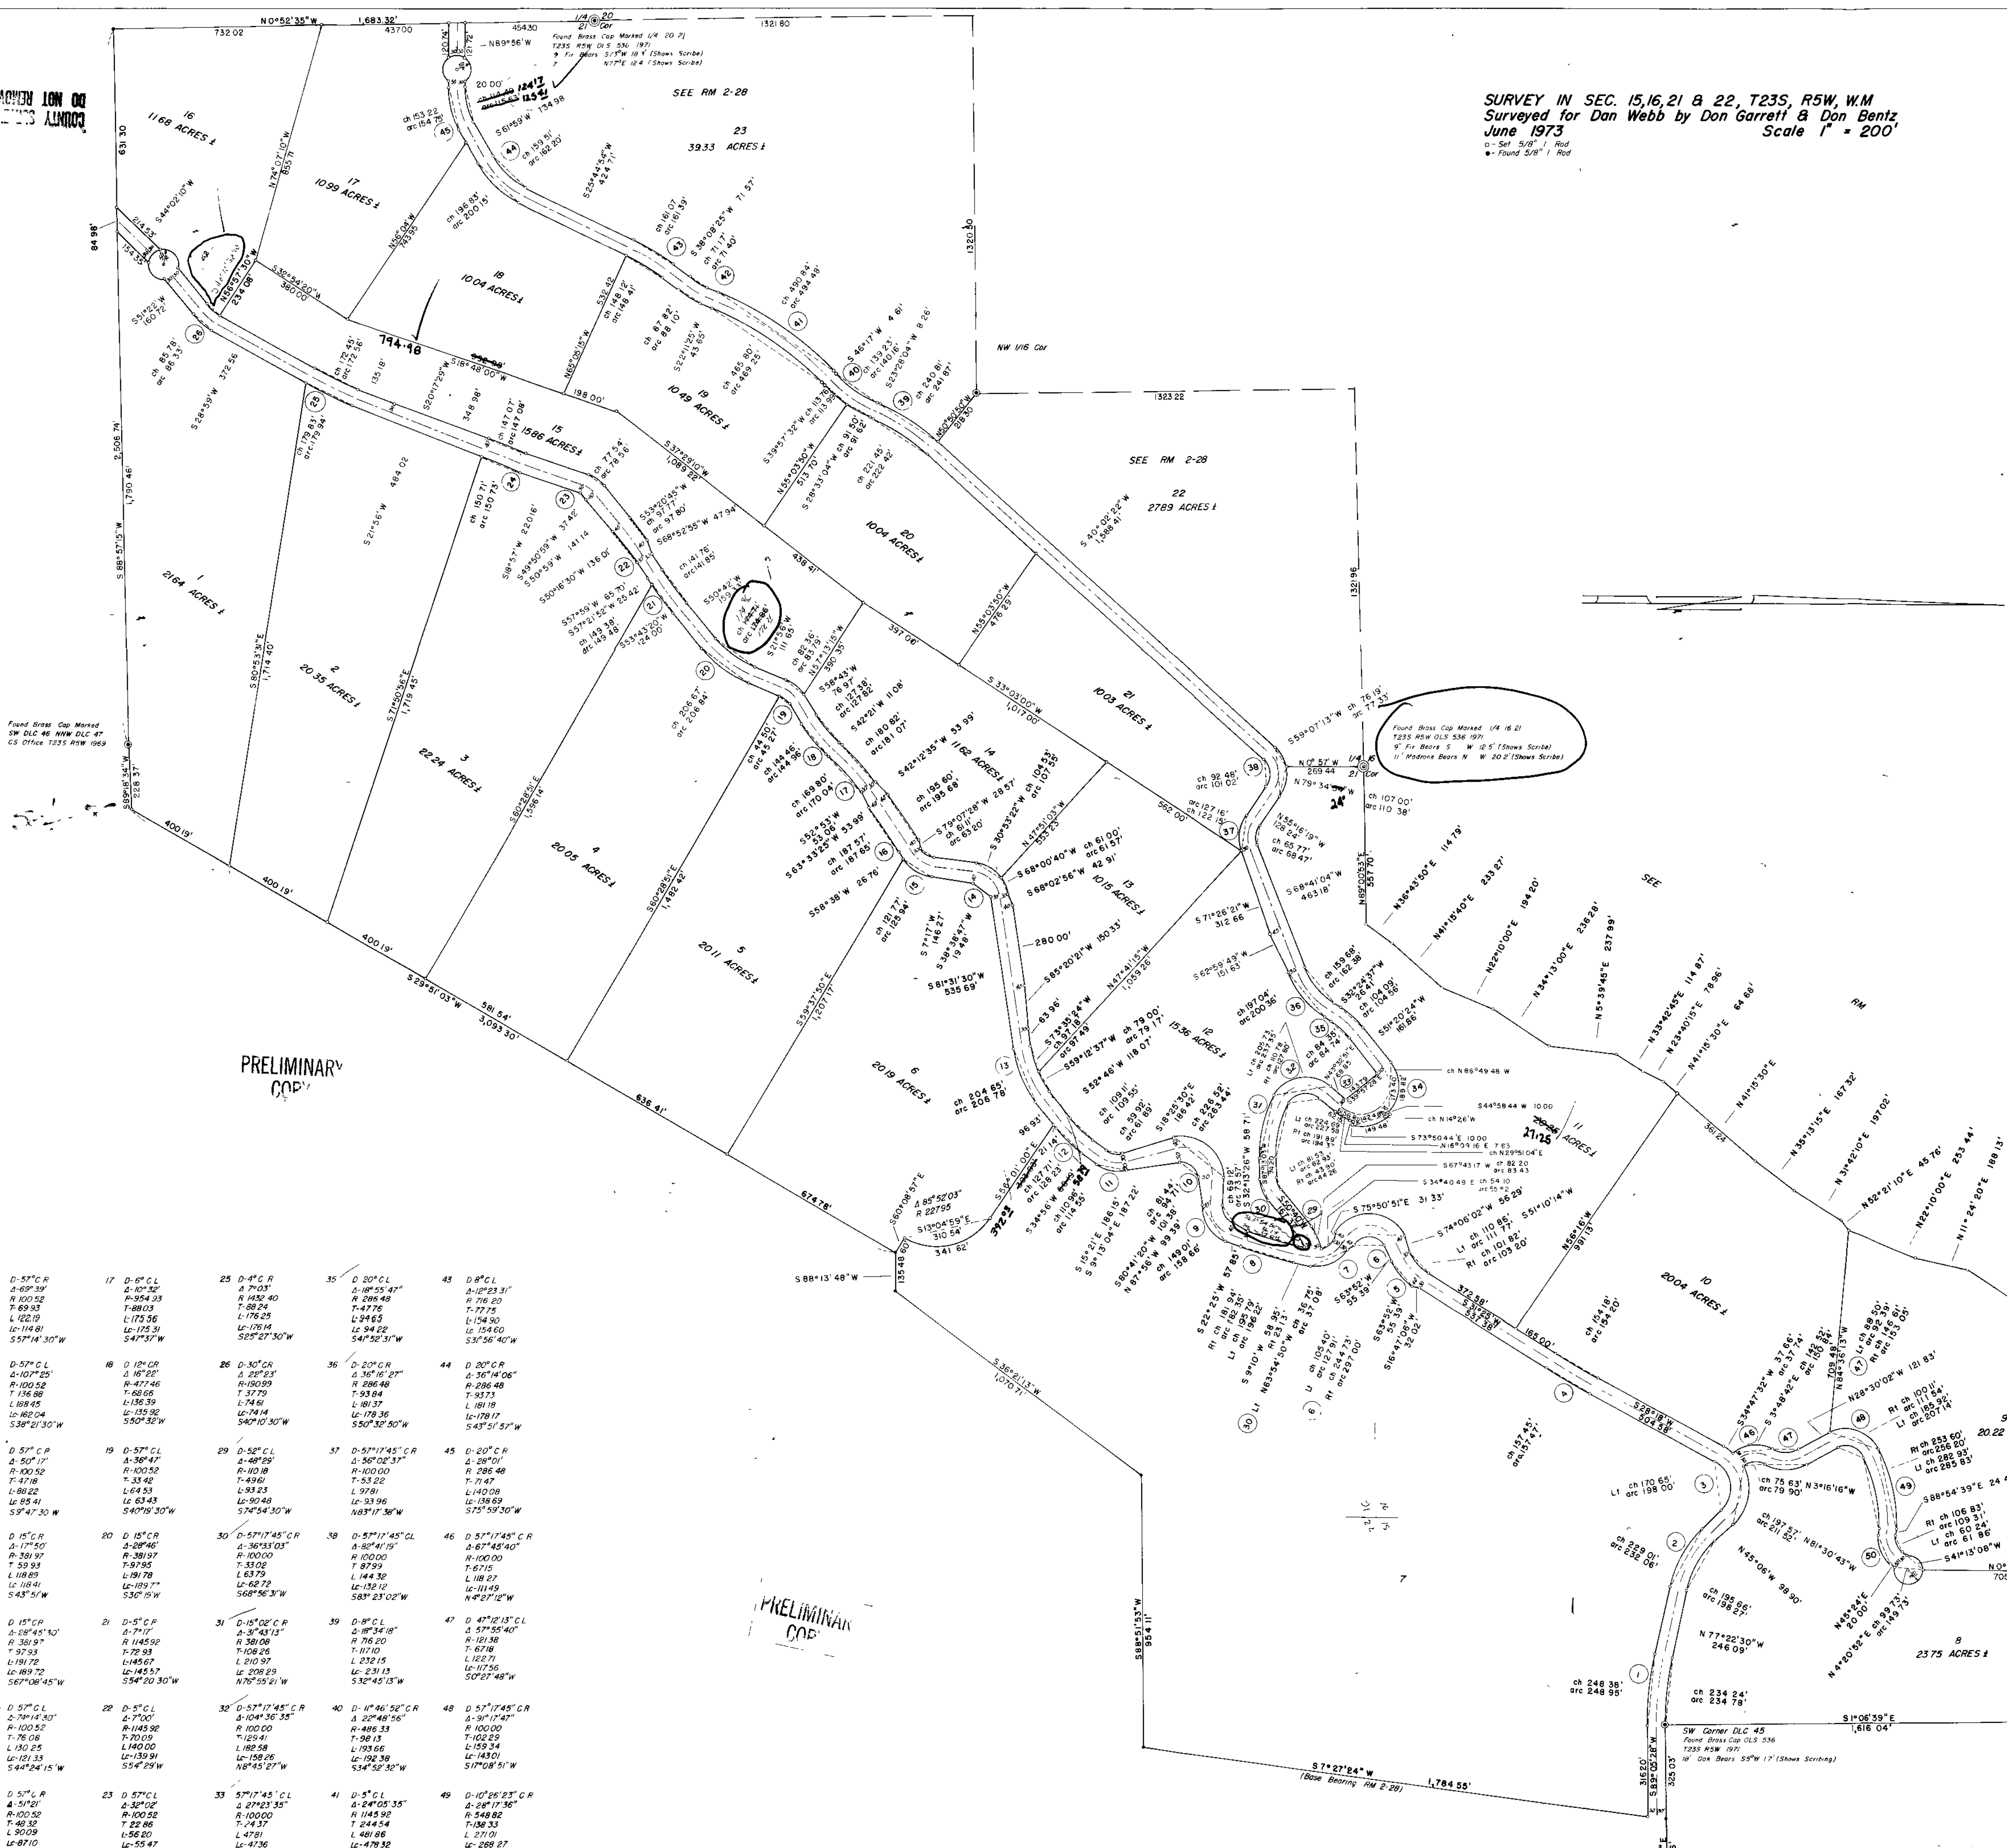










PRELIMINARY COE

COUNTY SURVEYORS FILE DATA
DO NOT REMOVE FROM OFFICE

PRELIMINARY
CORRECTIONS
CIRCLED IN RED

