


NW CORNER WEST ~ 19.70 CH. WEST 35.51 CH. NE CORNER D.L.C. No. 47

J. Q. C. VANDENBOSCH D.L.C. No. 47

COUNTY ROAD # 283

Vol. 10A P. 442

(EXCEPTION)

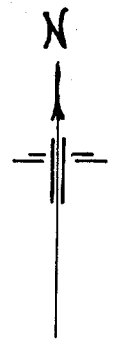

790.0

15.70 CH.

FD 3/4" IP

INST #339085

1.84 ACRES

N 36° E

19.90 CH.

VICINITY MAP SCALE: 1" = 200'

PLOT PLAN

SCALE: 1" = 100'

NW CORNER D.L.C. No. 47

S 42° 00' E 790.0

SET 3/4" IP

BASE OF BEARINGS S 42° 00' E ~ 285.80 S 42° 00' E

1.84 ACRES

N 57° 00' W ~ 255.170

47.04

COUNTY ROAD # 151 30° E ~ 320.10

FILED RECEIVED

OCT 12 1973

COUNTY SURVEYOR DOUGLAS COUNTY, ORE. md



FIELD SURVEY & PLAT FOR JAMES FOGUS RIDDLE, OREGON

J. Q. C. VANDENBOSCH D.L.C. No. 47 SE 1/4 SEC. 14 T30S R6W W.M. DOUGLAS COUNTY, ORE.

MARTIN ENGINEERING SERVICE ~ MYRTLE CREEK

MARCH 1967

C.S. File No. 55/317-5