COUNTY SURVEYORS FILE DATA
DO NOT REMOVE FROM OFFICE

FILED
RECEIVED
JAN 6 1975
COUNTY SURVEYOR
DOUGLAS COUNTY, ORE.

C. S. File No. 55/319-3

SURVEY FOR FRANK GUIDO FOR FINANCING PURPOSES

LOCATED IN SEC. 4, T 27S, R6W, W.M.

JAN., 1975

BY HAROLD BALL - CIVIL ENGINEER

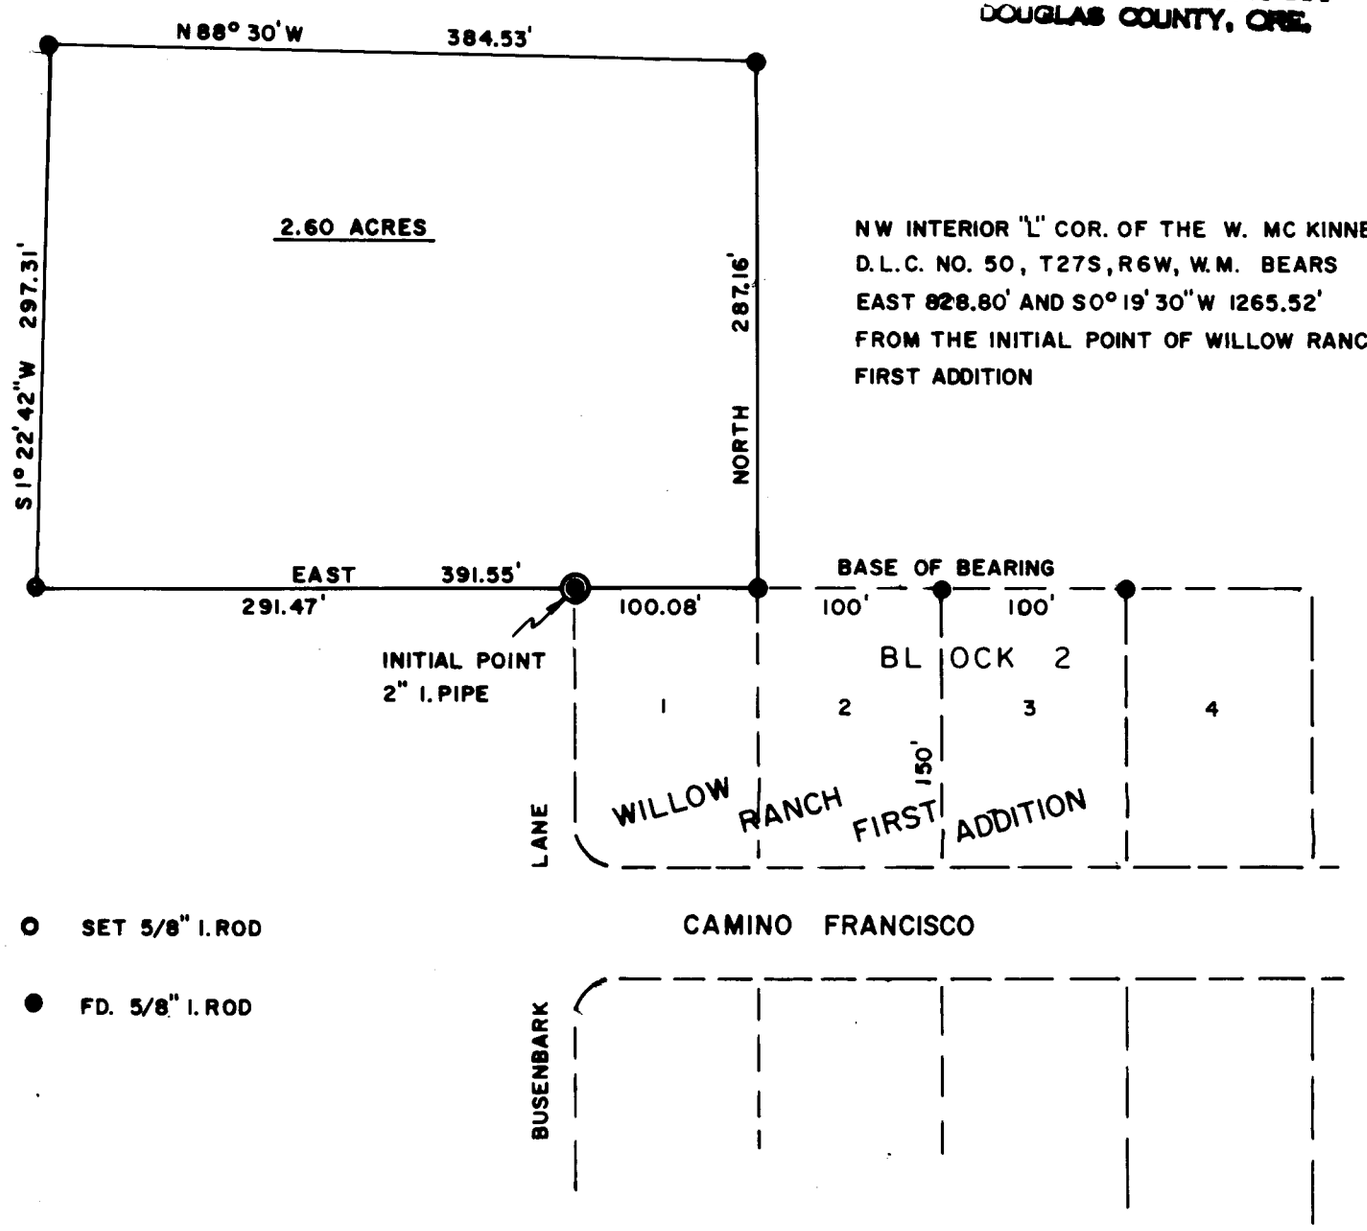

NW INTERIOR "L" COR. OF THE W. MC KINNEY D.L.C. NO. 50, T27S, R6W, W.M. BEARS EAST 828.80' AND S0° 19' 30" W 1265.52' FROM THE INITIAL POINT OF WILLOW RANCH FIRST ADDITION

REGISTERED PROFESSIONAL ENGINEER
6025
Harold L. Ball
OREGON
SEPT. 8, 1967
HAROLD L. BALL