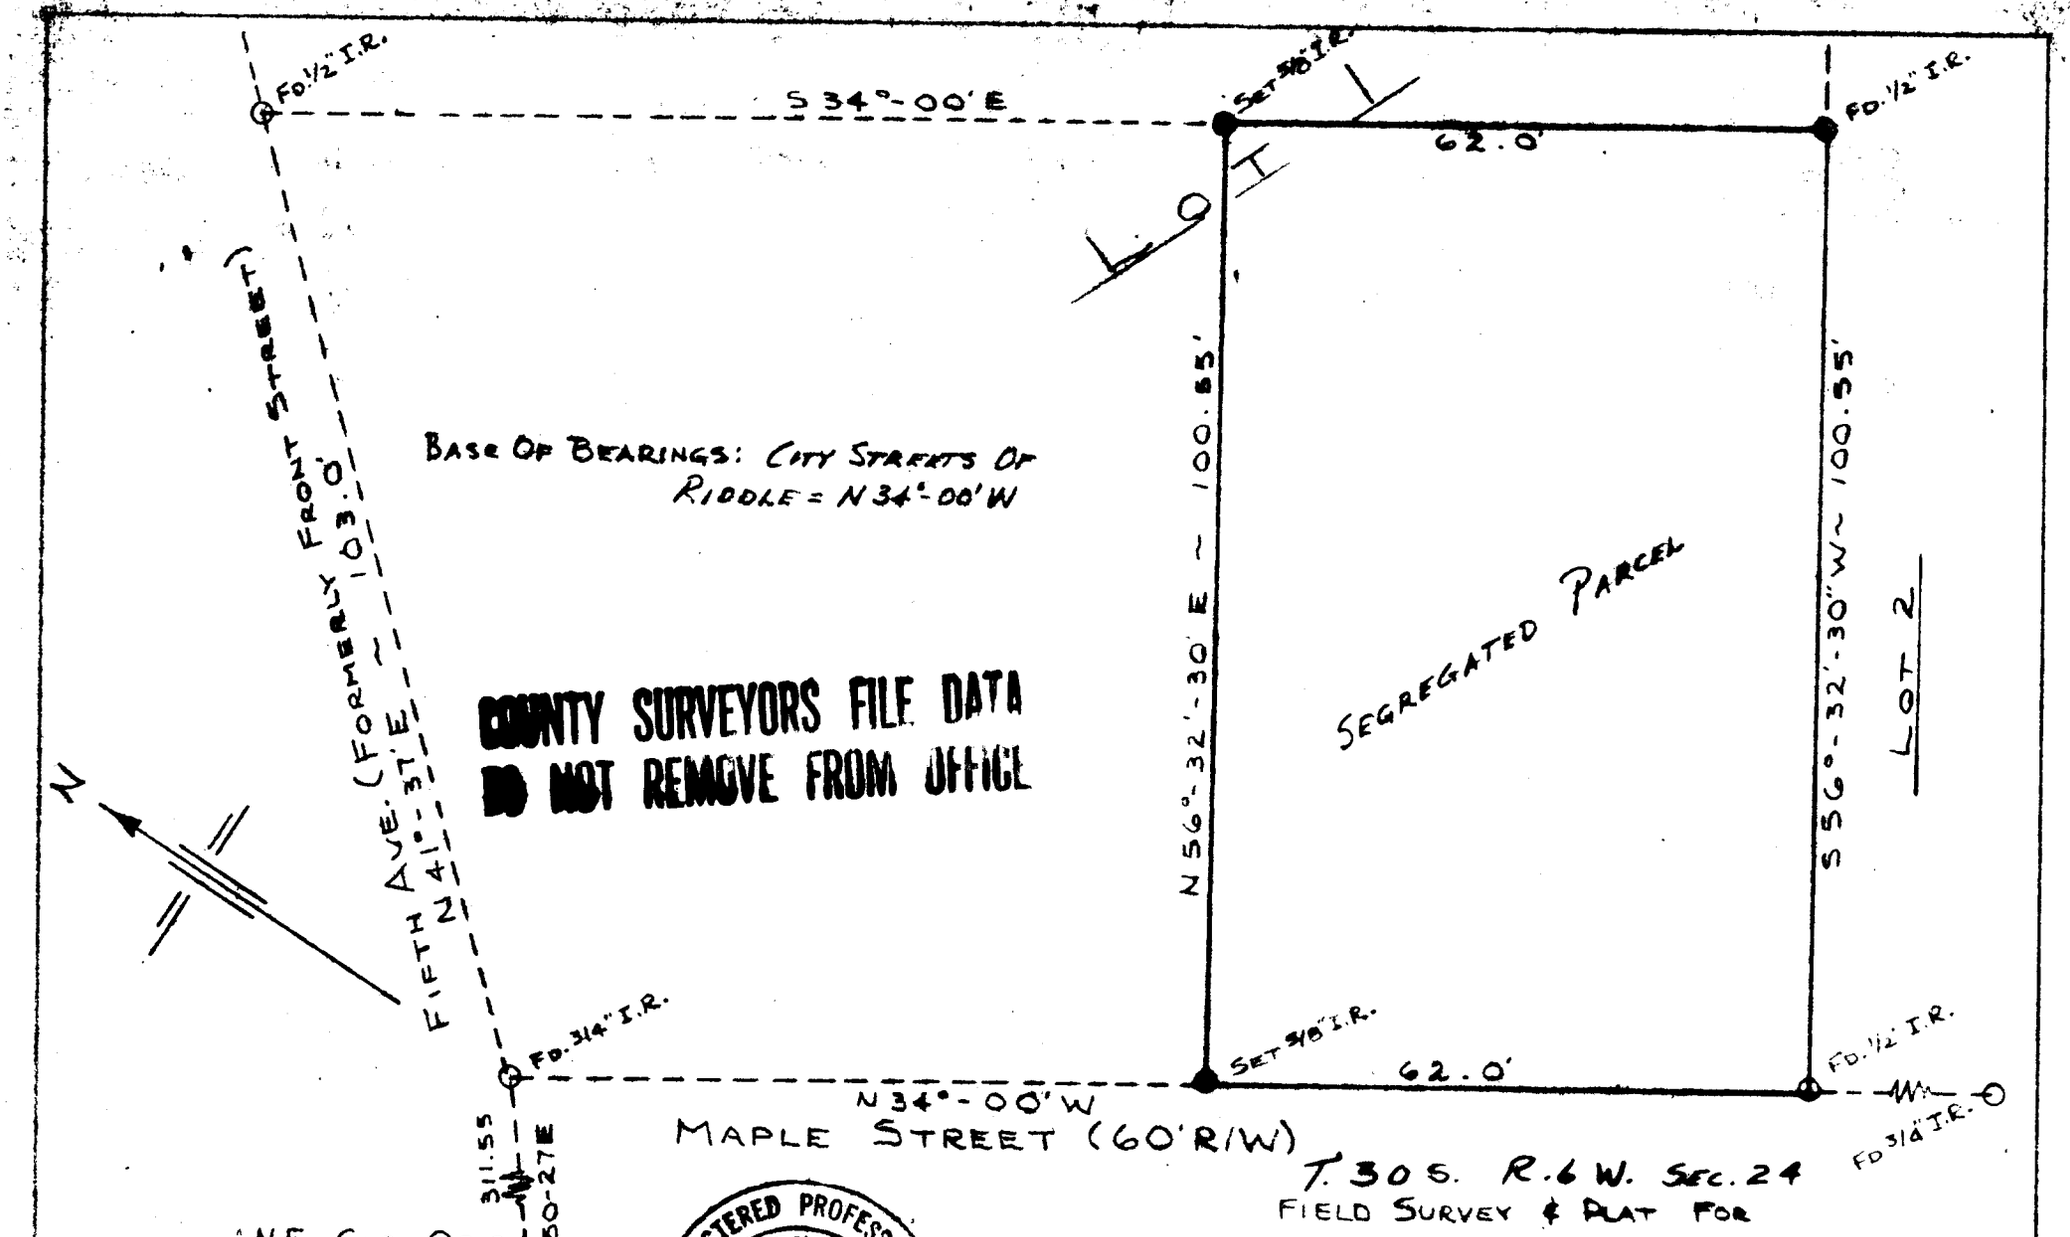

COUNTY SURVEYORS FILE DATA
DO NOT REMOVE FROM OFFICE

T. 30 S. R. 6 W. SEC. 24

FIELD SURVEY & PLAT FOR

ALBERT WEATHERS

RIDDLE, OREGON

PART OF LOT 1 OF

"MAPLE PARK ADDITION" TO RIDDLE

DOUGLAS COUNTY, OREGON

SCALE: 1" = 20'

MARTIN ENGINEERING SERVICE ~ MYRTLE CREEK, OREGON

FILED
RECEIVED
JAN 14 1974
COUNTY SURVEYOR
DOUGLAS COUNTY, ORE.

APRIL 1974