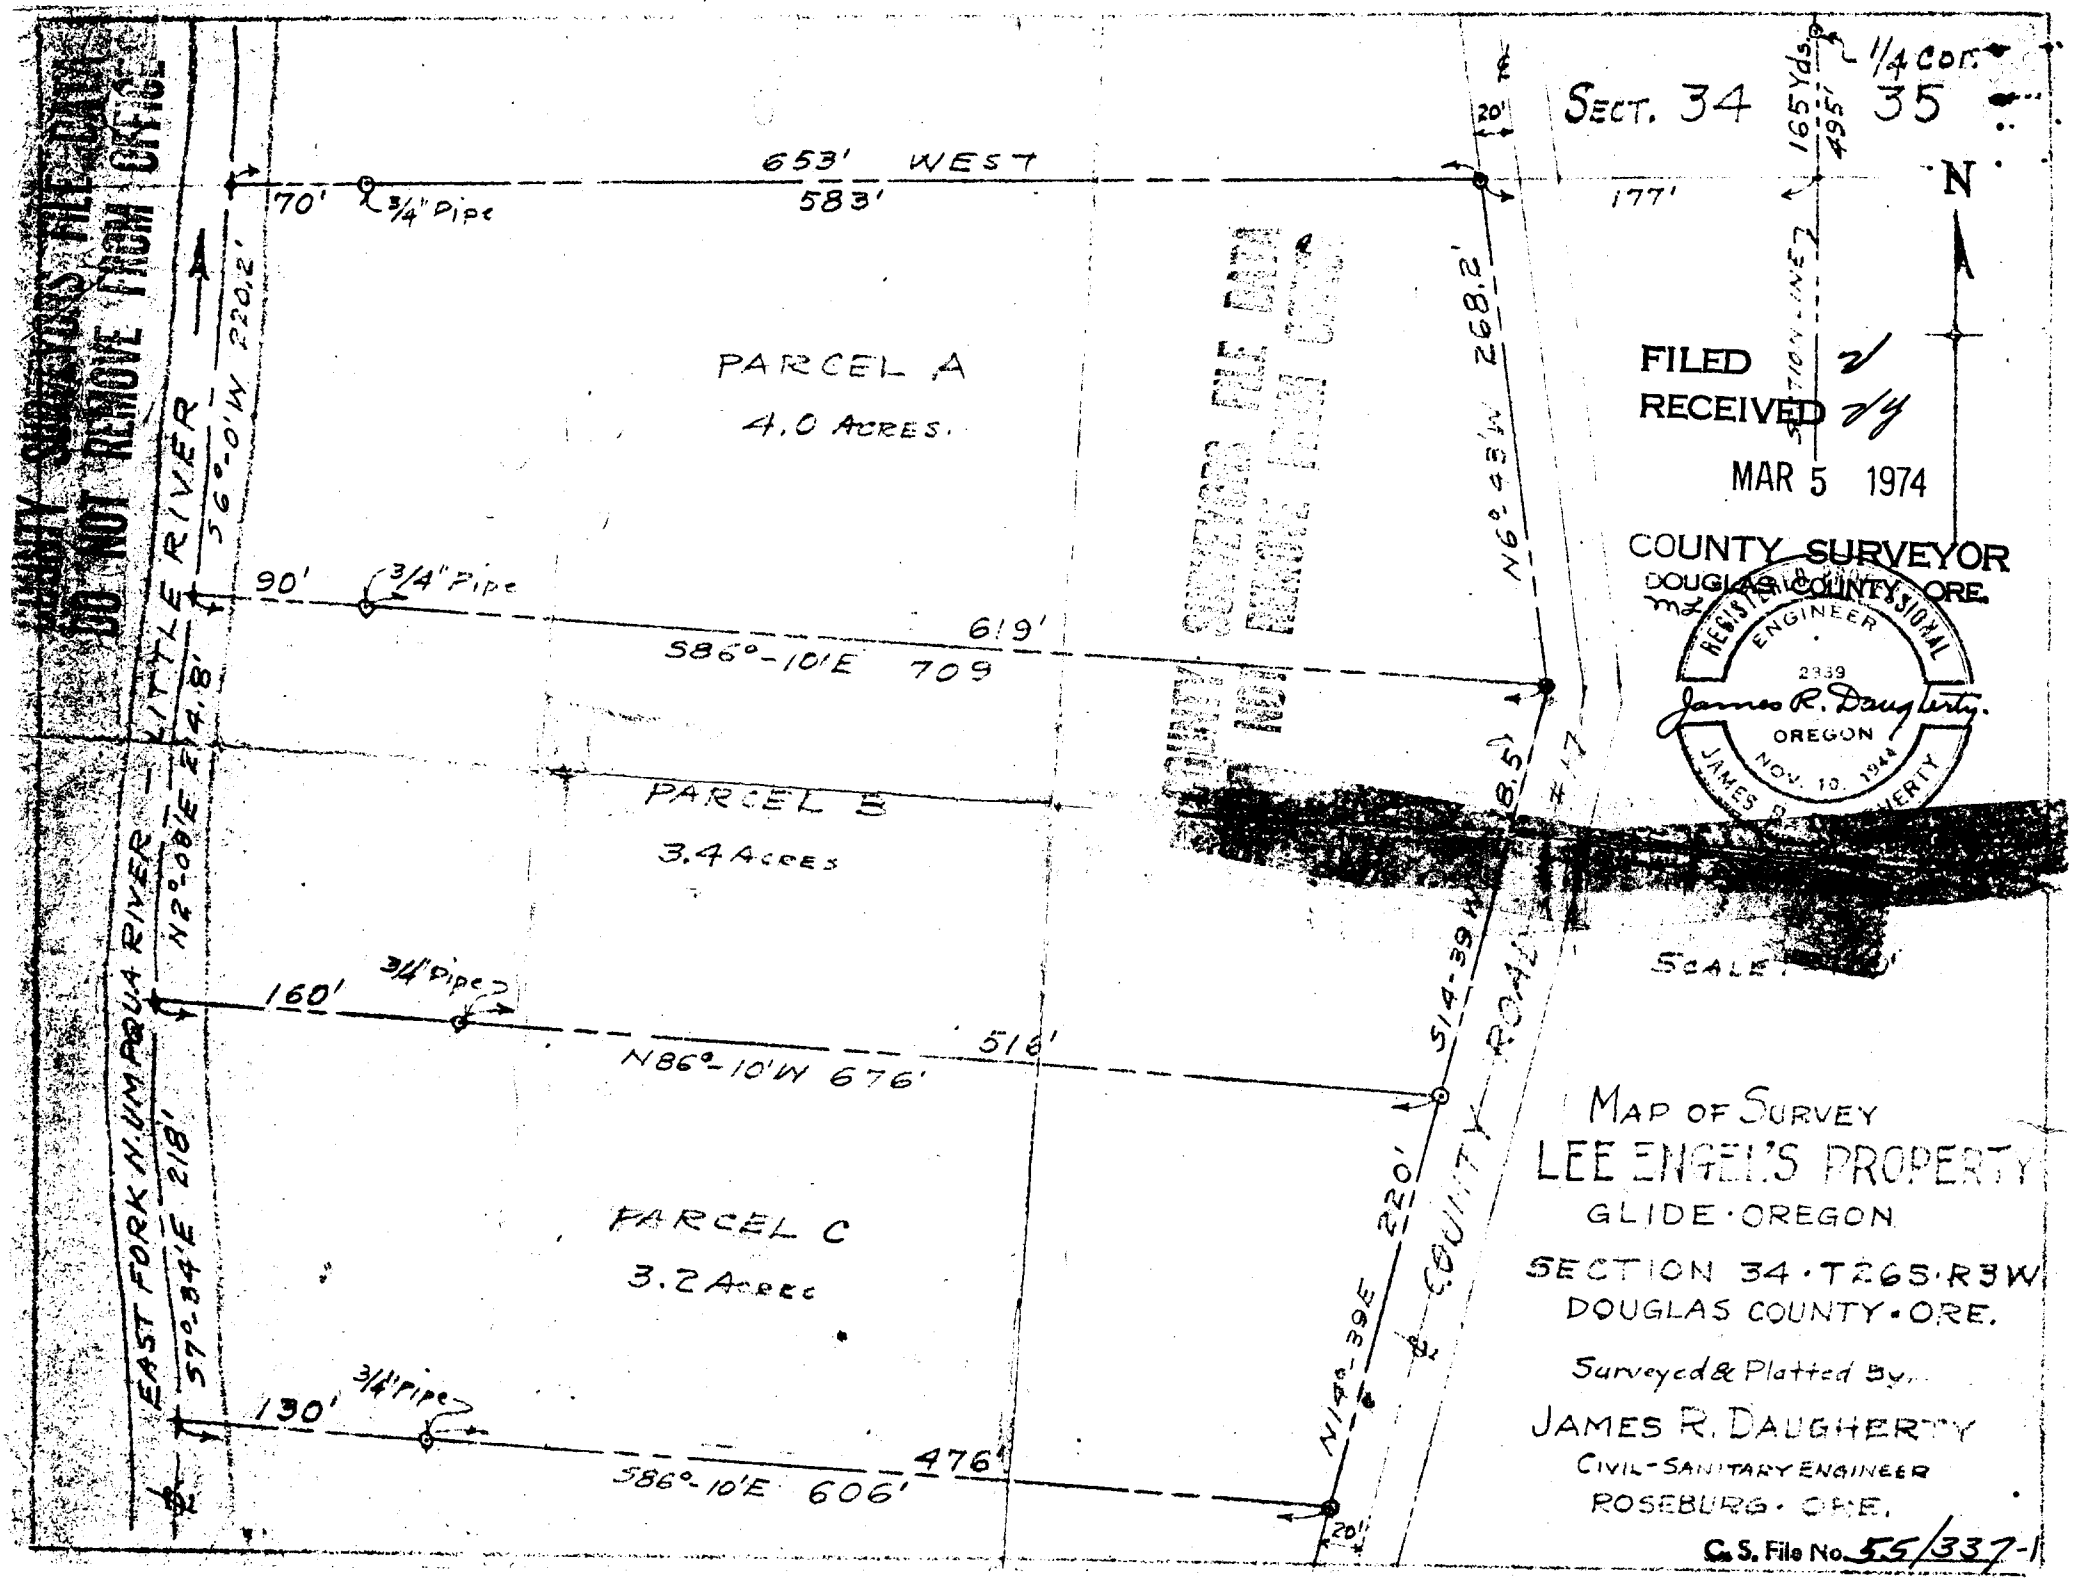COUNTY SURVEYOR'S FILE COPY
DO NOT REMOVE FROM OFFICE