FILED
RECEIVED

MAR 19 1974

COUNTY SURVEYOR
DOUGL[redacted]TY, ORE.

[redacted]

PROPERTY SURVEY
FOR
ARTHUR L. SMITH

SEC. 18, T22S, R 9 W.
MAY, 1972 SCALE 1"=100'

CORNERS FND. ◎
SET 5/8" I.R.'S o

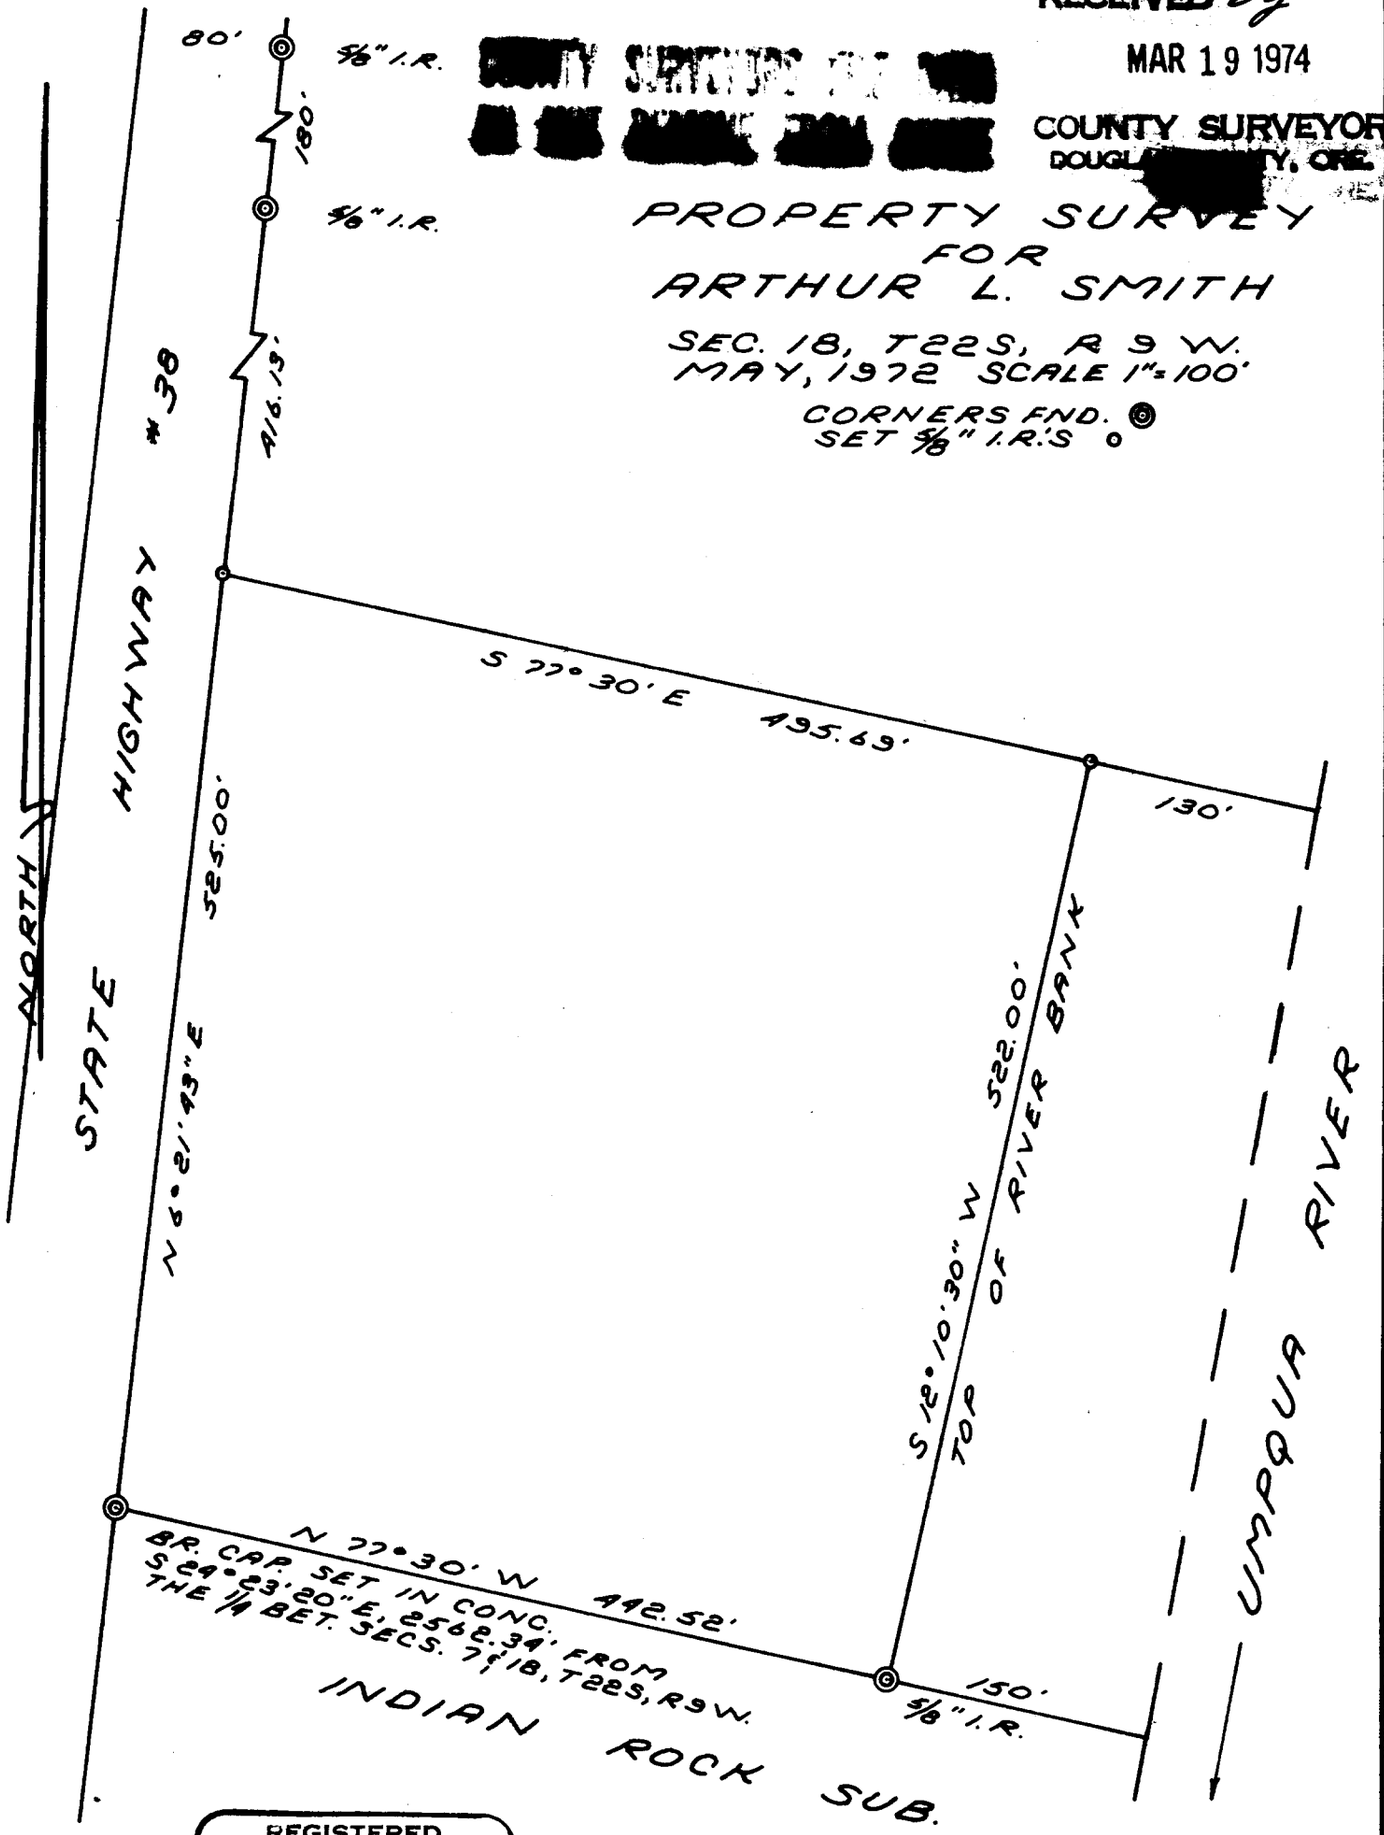

REGISTERED
PROFESSIONAL
LAND SURVEYOR

Richard J. Hintz

OREGON
MAY 13, 1960
RICHARD J. HINTZ
497

U. S. File No. 55/3440 - 1