see Rec. #1

T 25 S R 5 W Sec. COR

S21	S 22
S28	S 27

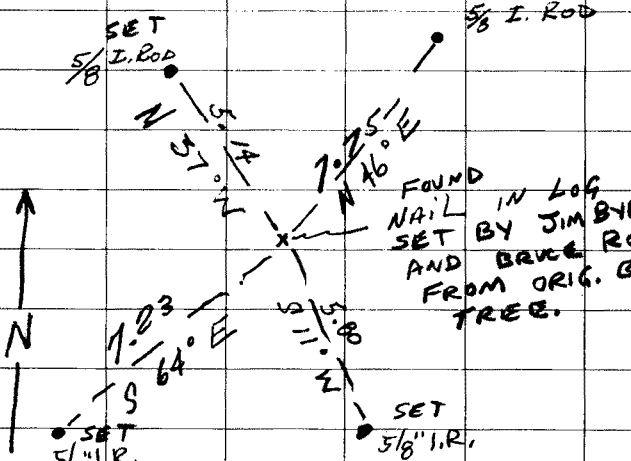

Jan 22, 1973
Jack Heritage
C. E. C.

O.K.

#117

C. S. File No. 56/25-1