

11-6-74

T295

$\frac{1}{4}$ $\frac{33}{4}$ R9W

T305

FO:

BOTH ORIGINAL BEARING TREES.

AT THE CORNER POINT WE SET A 1" X 30" IRON PIPE WITH BRASS CAP ATTACHED, MARKED:

COUNTY SURVEYORS OFFICE

T 295
 $\frac{1}{4}$ $\frac{S 33}{S 4}$ R 9 W
T 305
1974

FROM WHICH:

AN ORIG. 18" D. FIR, NOW A 30" STUMP BEARS N 23° E 20 5 FT. WE OPEN AND FIND GOOD ECKING "T"

AN ORIG. 15" D. FIR, NOW A 36" STUMP BEARS S 32° W 27 8 FT., (REG. S 32° W 26 4 FT.), SHOWING A GOOD SCAR AND

#112 T30-9 ✓
#113 T30-9 ✓
#114 T30-9 ✓

DIETZGEN NO. 3895-6

OBT SW

28^S@ 12^{1/2}° 9762

27^{100%}

S 33° W

NEW NEST 12" HEMLOCK

16^S LWL


1/4 S 33 CSRT

N 77 1/2° E

NW BT 11" PO CEDAR

14^Z LWL

N 12° W

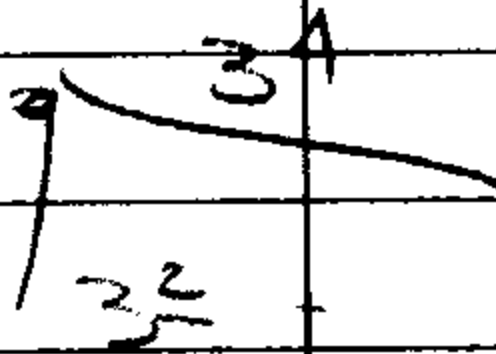

DOWNHILL

FAINT SCRIBE MARKS ON THE BARK ABOVE
THE SCAR!

WE MARK THE FOLLOWING BEARING TREES:

A 12" HEMLOCK BEARS $N 77\frac{1}{2}^{\circ} E$ 16 $\frac{3}{4}$ FT.,
SCRIBED " $\frac{1}{4}$ S33 CS BT

AND AN 11" PORT ORFORD CEDAR BEARS $N 12^{\circ} E$
14 $\frac{3}{4}$ FT., SCRIBED " $\frac{1}{4}$ S33 CS BT".

COMPASS DECLINATION SETTING: 20° EAST

11-6-74

Gary L. Knight
PETER L. EARLE

OK
EAR