SURVEY OF ROAD EASEMENT IN LOTS 79 & 80, EDEN ORCHARDS
SURVEYED FOR CARLESS HAMLIN BY DON E. GARRETT
AUGUST 1974 T27-7 S.3 SCALE 1" = 100'

COUNTY SURVEYORS FILE DATA
DO NOT REMOVE FROM OFFICE

FILED
RECEIVED
AUG 27 1974
COUNTY SURVEYOR
DOUGLAS COUNTY, ORE.

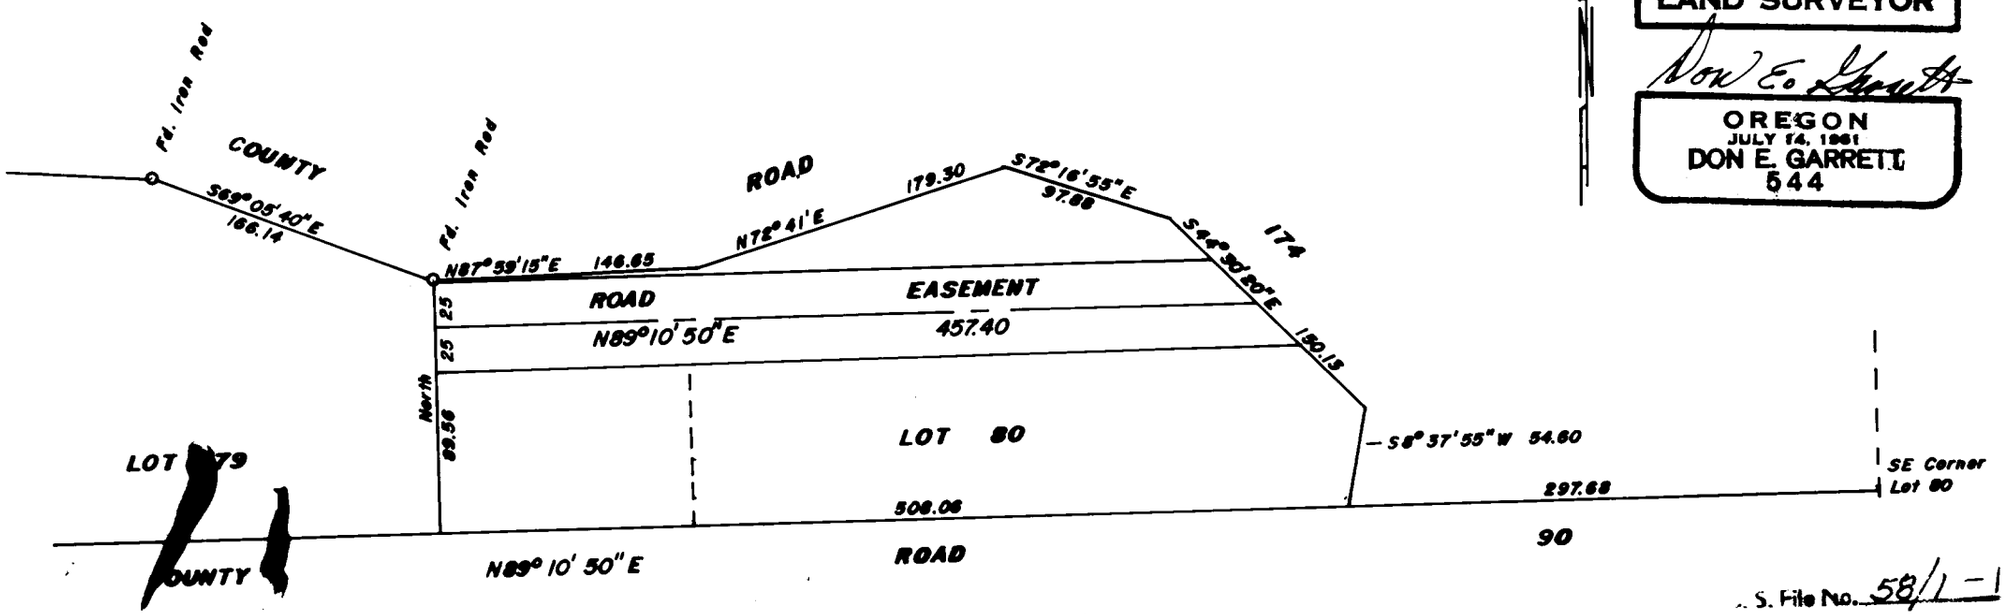

REGISTERED
PROFESSIONAL
LAND SURVEYOR
Don E. Garrett
OREGON
JULY 14, 1961
DON E. GARRETT
544

S. File No. 58/1-1