

FILED  
RECEIVED *JK*

DEC 22 1980

COUNTY SURVEYOR  
DOUGLAS COUNTY, ORE.

PUBLIC LAND CORNERS

WEYERHAEUSER COMPANY  
  
TOWNSHIP 23S  
SECTION 36  
COUNTY Douglas

SPRINGFIELD BRANCH  
  
RANGE 2W  
CORNER SE  
OREGON

GLO RESURVEY RECORD 1964	PRESENT CONDITION
Restoring 1894 GLO Survey by H. L. Chandler.	March 10, 1978
Set brass cap, the corner point determined by distances from the faces of the original bearing trees:	Found brass cap not disturbed by adjacent timber felling.
50" Fir S48E 35 Lks - 23.1'. (Record S58E 32 Lks) with healed blaze.	50" Fir stump, S48E 22.0' to face, 24.0' center measurement; no scribing four
* 44" Hemlock S38W 33 Lks - 21.8'. (Record S38W 30 Lks) with scribe marks visible.	36" Hemlock S38W 18.0' to face, 19.3' center measurement; scribing visible on mostly healed face.
* 38" White Fir N68W 36 Lks - 23.8' (Record N68W 33 Lks) with scribe marks visible on open blaze.	32" White Fir snag N66W 20.8' to face, 21.9' center measurement; scribing, extremely fine, on round surface of tree, not on a flat face.
New (1964) BT:	
* 17" White Fir N33½E 46 Lks - 30.4'.	18" White Fir N34E 30.7', center measurement; scribing visible.
* BLM BT plates on these BTs.	

CONTINUED  
CORNER:

PUBLIC LAND CORNERS - MEYERHAEUSER COMPANY - SPRINGFIELD  
SE Section 36, T23S, R2W

ACCESSORIES ADDED THIS DATE

MARCH 10, 1978

Bearings and distances are to "W" nails driven into base of reference trees;

Weyerhaeuser plates on trees:

64" Fir N8W 61.3'.

48" Fir stump S48E 21.1' Original BT.

Slope: N60E - 60%

North: -35%

East: - 52%

South: +38%

West: + 55%

Work done for Weyerhaeuser Company


Under the supervision of:

By: Glen Mc Chesney


Frank O. Williams

Date: 3/10/1978

R.P.L.S. No. 0875.

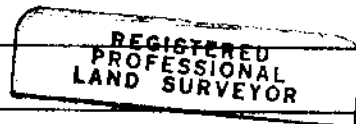

*Frank O. Williams*

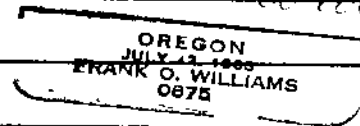

T23-2 #35 X  
T23-1 #13 X  
T24-2 #103 X  
T24-1 #186 X

FILED  
RECEIVED *VR*  
DEC 22 1980  
COUNTY SURVEYOR  
DOUGLAS COUNTY, ORE