


PUBLIC LAND CORNERS

FILED
RECEIVED

JUN 3 1981

WEYERHAEUSER COMPANY COUNTY SURVEYOR
 SPRINGFIELD BRANCH DOUGLAS COUNTY, ORE.

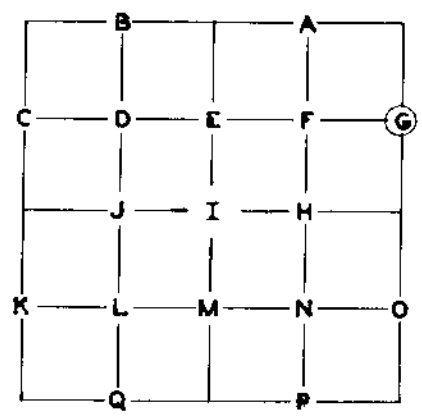

TOWNSHIP 23S RANGE 4W
 SECTION 12 CORNER N1/16 "C"
 COUNTY Lane - Douglas Line OREGON

| GLO SURVEY RECORD | | | |
|------------------------------|--------|-------|--|
| DATE: _____ | | | |
| CORNER <u>Not set by GLO</u> | | | |
| ACCESSORIES: | | | |
| BEARING- | LINKS- | FEET- | |
| | | | |
| | | | |
| | | | |
| | | | |
| | | | |

PRESENT CONDITION - (DESCRIBE FULLY -
 USE PAGE 2 IF NEEDED FOR EXPLANATION.)

| | |
|---------------------------|------------------------|
| W. N. Haines | SURVEY RECORD |
| Transit Survey | DATE: <u>Nov. 1963</u> |
| Set "T" iron and scribed: | |
| 6" Red Cedar S29W 19.7' | |
| 8" Red Cedar S8E 21.6' | |

PRESENT CONDITION:

Found "T" iron in place

8" Red Cedar Scribing visible

9" Red Cedar Scribing visible

CORNER SET: "T" iron as set by Haines' Survey MAG. DECL.: 20°

| BEARING AND DISTANCE TO ABOVE IDENTIFIED SURVEY ACCESSORIES: | | | |
|--|-------|------------|-----------------|
| BEARING- | FEET- | SURVEY - | |
| S29W | 19.4' | Haines' 63 | to scribed face |
| S8E | 21.2' | " | " " " |
| | | | |
| | | | |
| | | | |

ACCESSORIES ADDED THIS DATE:

MAGNETIC DECLINATION 20°

| | BEARING | FEET | ORIG. B.T. | "W" NAIL | PLATE | BRASS DISC |
|--------------|---------|------|----------------|----------|-------|------------|
| 28" Fie | S61W | 21.1 | Haines 1963 | X | X | -- |
| 9" Red Cedar | S9E | 21.0 | " | X | X | -- |
| | | | | | | |
| | | | | | | |

IDENTIFIED ON PHOTO:

INFORMATION ON LOCATION OF CORNER AS NOW SET:

GROUND COVER: Salal, Willow, Fir reproduction

(USING FORM LINES SKETCH TOPOG AT CORNER ON PAGE 2 PLAT)

SLOPE FACES (GIVE BEARING IN DEGREES) N80W ON MINUS (-) 50 %

NORTH: -10%

SOUTH: +25%

EAST: +75% 45' to old logging road

WEST: -45%

FROM CORNER |

FILED
RECEIVED

JUN 3 1981

COUNTY SURVEYOR
DOUGLAS COUNTY, ORE.

WORK DONE FOR W. CO.

FIELD NOTES IN BOOK:

BY: Glen McChesney DATE: 8/8/68
ENGINEER - SURVEYOR

ASSISTED BY:

COPIES SENT TO:

UNDER THE SUPERVISION OF:

| | | | | | | | |
|----|----|----|----|----|----|----|----|
| 36 | 31 | 32 | 33 | 34 | 35 | 36 | 31 |
| 1 | 6 | 5 | 4 | 3 | 2 | 1 | 6 |
| 12 | 7 | 8 | 9 | 10 | 11 | 12 | 7 |
| 13 | 18 | 17 | 16 | 15 | 14 | 13 | 18 |
| 24 | 19 | 20 | 21 | 22 | 23 | 24 | 19 |
| 25 | 30 | 29 | 28 | 27 | 26 | 25 | 30 |
| 36 | 31 | 32 | 33 | 34 | 35 | 36 | 31 |
| 1 | 6 | 5 | 4 | 3 | 2 | 1 | 6 |

WEYERHAEUSER COMPANY

CORNER REFERENCE METHOD CONSISTS OF:

A "W" NAIL DRIVEN THRU THE HOLE IN A BRASS DISC, INTO A NOTCH CUT LOW ON A TREE, STAMPED WITH THE OREGON REGISTERED LAND SURVEYOR OR PROFESSIONAL ENGINEER REGISTRATION NUMBER.

AN EMBOSSED ALUMINUM PLATE, NAILED HEAD HIGH ON SAME TREE WITH 8D ALUMINUM NAILS, WITH DISTANCE AND BEARING FROM THE "W" NAIL TO THE CORNER STAMPED ON IT.

