

PUBLIC LAND CORNERS


FILED
RECEIVED ✓

JUN 3 1981

WEYERHAEUSER COMPANY

SPRINGFIELD BRANCH

COUNTY SURVEYOR
DOUGLAS COUNTY, ORE.
4W

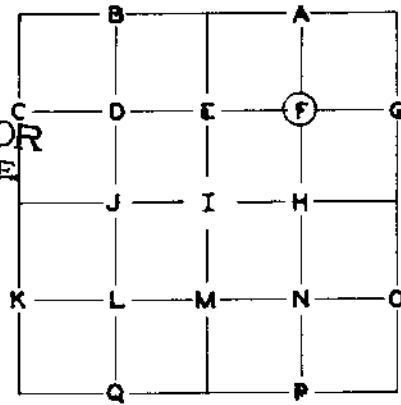

TOWNSHIP 23S RANGE _____
SECTION 12 CORNER NE 1/4 "F"
COUNTY Douglas OREGON

GLO SURVEY RECORD

PRESENT CONDITION - (DESCRIBE FULLY - USE PAGE 2 IF NEEDED FOR EXPLANATION.)

Not set by GLO
CORNER _____

ACCESSORIES:

	BEARING-	LINKS-	FEET-

W. N. Haines SURVEY RECORD
DATE: Nov. 1963

PRESENT CONDITION: _____

Transit Survey
Set "T" iron and scribed;

Found "T" iron in place

14" Red Cedar N10^W91.7°

16" Red Cedar in dying condition.
Scribing visible.

(Haines scribed only 1 BT)

CORNER SET: "T" iron as set by Haines' Survey

MAG. DECL.: 20°

BEARING AND DISTANCE TO ABOVE IDENTIFIED SURVEY ACCESSORIES:

BEARING-	FEET-	SURVEY
<u>N10^W</u>	<u>90.7</u>	<u>Haines '63</u>

to scribed face

ACCESSORIES ADDED THIS DATE:

MAGNETIC DECLINATION 20°

	BEARING	FEET	ORIG. B.T.	"W" NAIL	PLATE	BRASS DISC
36" Red Cedar Stump	S6W	4.9	--	X	X	--
16" Red Cedar	N10W	90.6	Haines 1963	X	X	

IDENTIFIED ON PHOTO:

INFORMATION ON LOCATION OF CORNER AS NOW SET:

GROUND COVER: Old logged area -- brush, fern, fir reproduction

(USING FORM LINES SKETCH TOPOG AT CORNER ON PAGE 2 PLAT)

SLOPE FACES (GIVE BEARING IN DEGREES) S45W ON MINUS (-)²³ %

NORTH: +20%

SOUTH: -22%

EAST: +20%

WEST: -10%

FROM CORNER |

FILED
RECEIVED

JUN 3 1981

COUNTY SURVEYOR
DOUGLAS COUNTY, ORE

WORK DONE FOR W. CO. _____

FIELD NOTES IN BOOK: _____

BY: Glen McChesney DATE: 8/8/68
ENGINEER - SURVEYOR

ASSISTED BY: _____

COPIES SENT TO: _____

UNDER THE SUPERVISION OF:

SEAL

PAGE 3

C. S. File No. 5813

36	31	32	33	34	35	36	31
1	6	5	4	3	2	1	6
12	7	8	9	10	11	12	7
13	18	17	16	15	14	13	18
24	19	20	21	22	23	24	19
25	30	29	28	27	26	25	30
36	31	32	33	34	35	36	31
1	6	5	4	3	2	1	6

WEYERHAEUSER COMPANY

CORNER REFERENCE METHOD CONSISTS OF:

A "W" NAIL DRIVEN THRU THE HOLE IN A BRASS DISC, INTO A NOTCH CUT LOW ON A TREE, STAMPED WITH THE OREGON REGISTERED LAND SURVEYOR OR PROFESSIONAL ENGINEER REGISTRATION NUMBER.

AN EMBOSSED ALUMINUM PLATE, NAILED HEAD HIGH ON SAME TREE WITH 8D ALUMINUM NAILS, WITH DISTANCE AND BEARING FROM THE "W" NAIL TO THE CORNER STAMPED ON IT.

