


# PUBLIC LAND CORNERS

FILED  
RECEIVED *JK*

DEC 22 1980

WEYERHAEUSER COMPANY COUNTY SURVEYOR  
SPRINGFIELD BRANCH DOUGLAS COUNTY, ORE.

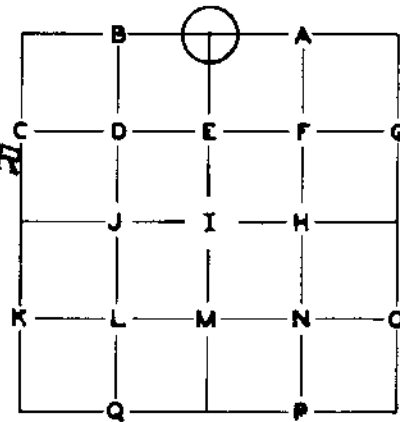

TOWNSHIP 25S RANGE 2W

SECTION 4 CORNER N $\frac{1}{2}$

COUNTY Douglas OREGON

**GLO SURVEY RECORD**

DATE: 1963

CORNER Brass cap (set by GLO 1951)

PRESENT CONDITION - (DESCRIBE FULLY - USE PAGE 2 IF NEEDED FOR EXPLANATION.)

Found brass cap.

**ACCESSORIES:**

	BEARING-	LINKS-	FEET-
42" Hemlock (1951 Bearing Tree)	N12W	42	27.7
14" Cedar (1963 Bearing Tree)	S33 $\frac{1}{2}$ W	79	52.1

42" Hemlock - Scribing visible. This tree will be removed by current road construction.

14" Red Cedar - Scribing visible. tree is at Westerly edge of R/W but should survive road construction.

**SURVEY RECORD**

DATE: \_\_\_\_\_

PRESENT CONDITION: \_\_\_\_\_

CORNER SET: Brass Cap to be reset after road construction. MAG. DECL.: 20<sup>o</sup>

**BEARING AND DISTANCE TO ABOVE IDENTIFIED SURVEY ACCESSORIES:**

BEARING-	FEET-	SURVEY -	
N11 $\frac{1}{2}$ W	27.4	1951-63	Center of tree measurement
S35W	52.6	1963	Center of tree measurement

# 114 T25-2 ✓  
# 107 T29-2 ✓

C



ACCESSORIES ADDED THIS DATE:

MAGNETIC DECLINATION 20°

	BEARING	FEET	ORIG. B.T.	"W" NAIL	PLATE	BRASS DISC
48" Fir	S49E	71.2	---	Y	X	---
40" Fir	S71W	69.0	---	X	X	---
13" Fir	N 6W	72.9	---	X	X	---

IDENTIFIED ON PHOTO:

INFORMATION ON LOCATION OF CORNER AS NOW SET:

GROUND COVER: \_\_\_\_\_

(USING FORM LINES SKETCH TOPOG AT CORNER ON PAGE 2 PLAT)

SLOPE FACES (GIVE BEARING IN DEGREES) \_\_\_\_\_ ON MINUS (-) \_\_\_\_\_ %

NORTH: 122%

SOUTH: -22%

EAST: Level for 50' then descend

WEST: +15% 25' then ascent steepens

FROM CORNER |

WORK DONE FOR W. CO.

FIELD NOTES IN BOOK: \_\_\_\_\_

BY: Glen McChesney  
Project Engineer  
ENGINEER - SURVEYOR

DATE: 7/13/1976

UNDER THE SUPERVISION OF:

REGISTERED PROFESSIONAL LAND SURVEYOR

*Frank O. Williams*

OREGON  
JULY 12, 1969  
FRANK O. WILLIAMS  
0875

ASSISTED BY: \_\_\_\_\_

FILED RECEIVED *[Signature]*

DEC 22 1980

COUNTY SURVEYOR  
DOUGLAS COUNTY, ORE.

COPIES SENT TO: \_\_\_\_\_

SEAL 58/8

36	31	32	33	34	35	36	31
1	6	5	4	3	2	1	6
12	7	8	9	10	11	12	7
13	18	17	16	15	14	13	18
24	19	20	21	22	23	24	19
25	30	29	28	27	26	25	30
36	31	32	33	34	35	36	31
1	6	5	4	3	2	1	6

## WEYERHAEUSER COMPANY

CORNER REFERENCE METHOD CONSISTS OF:

A "W" NAIL DRIVEN THRU THE HOLE IN A BRASS DISC, INTO A NOTCH CUT LOW ON A TREE, STAMPED WITH THE OREGON REGISTERED LAND SURVEYOR OR PROFESSIONAL ENGINEER REGISTRATION NUMBER.

AN EMBOSSED ALUMINUM PLATE, NAILED HEAD HIGH ON SAME TREE WITH 8D ALUMINUM NAILS, WITH DISTANCE AND BEARING FROM THE "W" NAIL TO THE CORNER STAMPED ON IT.

