


PUBLIC LAND CORNERS

FILED
RECEIVED

JUN 3 1981

WEYERHAEUSER COMPANY
SPRINGFIELD BRANCH

COUNTY SURVEYOR
DOUGLAS COUNTY, ORE.

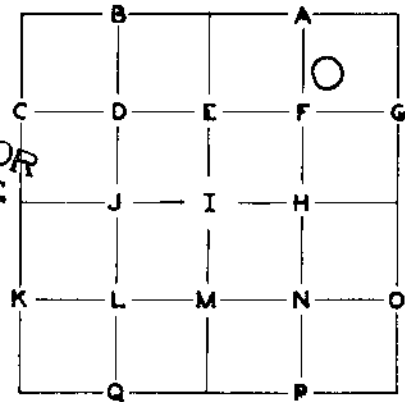

TOWNSHIP 25S RANGE 2W
SECTION 4 CORNER SW Tract 37
COUNTY Douglas OREGON

GLO SURVEY RECORD				PRESENT CONDITION - (DESCRIBE FULLY - USE PAGE 2 IF NEEDED FOR EXPLANATION.)
CORNER <u>Brass Cap</u> DATE: <u>1963</u>				
ACCESSORIES:				Found in place.
15" Fir	BEARING - <u>N43 1/4 E</u>	LINKS - <u>41</u>	FEET - <u>27.1</u>	
20" Fir	BEARING - <u>S76 1/4 E</u>	LINKS - <u>57</u>	FEET - <u>37.6</u>	
SURVEY RECORD				PRESENT CONDITION:
DATE: _____				

CORNER SET: XXXX brass cap as found MAG. DECL.: 20°E

BEARING AND DISTANCE TO ABOVE IDENTIFIED SURVEY ACCESSORIES:

BEARING - <u>N39E</u>	FEET - <u>25.9</u>	SURVEY - <u>1963</u>	<u>Center of tree measurement.</u>
<u>S73E</u>	<u>37.4</u>	<u>1963</u>	<u>Center of tree measurement.</u>

ACCESSORIES ADDED THIS DATE:

MAGNETIC DECLINATION

20°

(1 only)	BEARING	FEET	ORIG. B.T.	"W" NAIL	PLATE	BRASS DISC
46" Fir	N62W	40.0	---	X	X	---

IDENTIFIED ON PHOTO:

INFORMATION ON LOCATION OF CORNER AS NOW SET:

GROUND COVER: Fern, salal

(USING FORM LINES SKETCH TOPOG AT CORNER ON PAGE 2 PLAT)

SLOPE FACES (GIVE BEARING IN DEGREES) N40E ON MINUS (-) 80 %

NORTH: - 60% 160' to creek course Easterly

SOUTH: + 80%

EAST: - 55%

WEST: + 80%

FROM CORNER |

FILED
RECEIVED

JUN 3 1981

COUNTY SURVEYOR
DOUGLAS COUNTY, ORE.

WORK DONE FOR W. CO.

FIELD NOTES IN BOOK:

BY: Glen McChesney
Project ENGINEER - SURVEYOR

DATE: 8/1/1977

ASSISTED BY:

UNDER THE SUPERVISION OF:

COPIES SENT TO:

SEAL

C. S. File No. 5818 PAGE 3

36	31	32	33	34	35	36	31
1	6	5	4	3	2	1	6
12	7	8	9	10	11	12	7
13	18	17	16	15	14	13	18
24	19	20	21	22	23	24	19
25	30	29	28	27	26	25	30
36	31	32	33	34	35	36	31
1	6	5	4	3	2	1	6

WEYERHAEUSER COMPANY

CORNER REFERENCE METHOD CONSISTS OF:

A "W" NAIL DRIVEN THRU THE HOLE IN A BRASS DISC, INTO A NOTCH CUT LOW ON A TREE, STAMPED WITH THE OREGON REGISTERED LAND SURVEYOR OR PROFESSIONAL ENGINEER REGISTRATION NUMBER.

AN EMBOSSED ALUMINUM PLATE, NAILED HEAD HIGH ON SAME TREE WITH 8D ALUMINUM NAILS, WITH DISTANCE AND BEARING FROM THE "W" NAIL TO THE CORNER STAMPED ON IT.

