


PUBLIC LAND ^{FILED} CORNERS

RECEIVED *JL*
DEC 22 1980

WEYERHAEUSER COMPANY
SPRINGFIELD BRANCH

COUNTY SURVEYOR
DOUGLAS COUNTY, ORE.

TOWNSHIP 26S RANGE 2W
SECTION 8 CORNER CN1/16
COUNTY Douglas OREGON

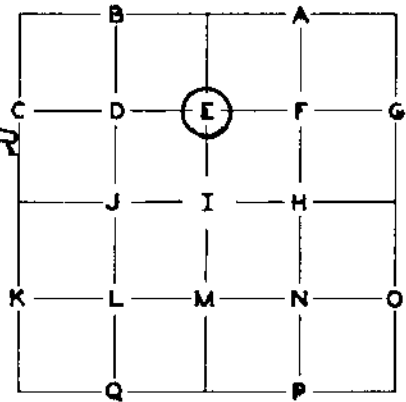

<p>GLO SURVEY RECORD</p> <p>CORNER <u>None</u> DATE: _____</p> <p>ACCESSORIES:</p> <table border="1" style="width:100%; border-collapse: collapse;"> <thead> <tr> <th style="width:15%;">BEARING-</th> <th style="width:15%;">LINKS-</th> <th style="width:15%;">FEET-</th> </tr> </thead> <tbody> <tr><td> </td><td> </td><td> </td></tr> <tr><td> </td><td> </td><td> </td></tr> <tr><td> </td><td> </td><td> </td></tr> <tr><td> </td><td> </td><td> </td></tr> <tr><td> </td><td> </td><td> </td></tr> <tr><td> </td><td> </td><td> </td></tr> <tr><td> </td><td> </td><td> </td></tr> <tr><td> </td><td> </td><td> </td></tr> </tbody> </table>	BEARING-	LINKS-	FEET-																									<p>PRESENT CONDITION - (DESCRIBE FULLY - USE PAGE 2 IF NEEDED FOR EXPLANATION.)</p> <hr/> <p>PRESENT CONDITION: _____</p> <p>Found 5/8" iron rod in place.</p> <p>24" Incense Cedar, scribing visible on upper and lower faces.</p> <p>10" Hemlock scribing visible on upper and lower faces.</p>
BEARING-	LINKS-	FEET-																										
<p>Baughman SURVEY RECORD DATE: <u>May 1975</u> Transit Survey for Weyerhaeuser Company Set 5/8" Iron rod Scribed: 1) 28" Cedar N81E 31.7' 2) 9" Hemlock S28½ E39.9'</p>	<p>PRESENT CONDITION: _____</p>																											

CORNER SET: XXXXX 5/8" iron rod as set by Baughman Survey MAG. DECL.: 20°

BEARING AND DISTANCE TO ABOVE IDENTIFIED SURVEY ACCESSORIES:

BEARING-	FEET-	SURVEY-	
1) N86E	32.0	Baughman	Center of tree measurement
2) S31E	40.2	"	Center of tree measurement

ACCESSORIES ADDED THIS DATE:

MAGNETIC DECLINATION

20°

	BEARING	FEET	ORIG. B.T.	"W" NAIL	PLATE	BRASS DISC
1) 24" Incense Cedar	N86½E	30.9	Baughman	X	X	---
2) 10" Hemlock	S31E	39.7	Baughman	X	X	---
46" Fir	S39E	19.2	---	X	X	---

IDENTIFIED ON PHOTO:

INFORMATION ON LOCATION OF CORNER AS NOW SET:

GROUND COVER: Huckleberry, old logging debris

(USING FORM LINES SKETCH TOPOG AT CORNER ON PAGE 2 PLAT)

SLOPE FACES (GIVE BEARING IN DEGREES) _____ ON MINUS (-) _____ %

NORTH: + 40%

FROM CORNER | SOUTH: - 40% approx. 120' to C of logging road

EAST: + 50%

WEST: - 55% approx. 55' to C of logging road

WORK DONE FOR W. CO. _____

FIELD NOTES IN BOOK: _____

BY: Glen McChesney DATE: 1/17/1977
Project ENGINEER - SUPERVISOR XXXXXXXXXX

UNDER THE SUPERVISION OF:

ASSISTED BY: _____

FILED

RECEIVED

JR

DEC 22 1980

COUNTY SURVEYOR
DOUGLAS COUNTY, ORE.

COPIES SENT TO: _____

REGISTERED PROFESSIONAL LAND SURVEYOR

Frank O. Williams

OREGON
JULY 12, 1968
FRANK O. WILLIAMS
0875

SEAL

36	31	32	33	34	35	36	31
1	6	5	4	3	2	1	6
12	7	8	9	10	11	12	7
13	18	17	16	15	14	13	18
24	19	20	21	22	23	24	19
25	30	29	28	27	26	25	30
36	31	32	33	34	35	36	31
1	6	5	4	3	2	1	6

WEYERHAEUSER COMPANY

CORNER REFERENCE METHOD CONSISTS OF:

A "W" NAIL DRIVEN THRU THE HOLE IN A BRASS DISC, INTO A NOTCH CUT LOW ON A TREE, STAMPED WITH THE OREGON REGISTERED LAND SURVEYOR OR PROFESSIONAL ENGINEER REGISTRATION NUMBER.

AN EMBOSSED ALUMINUM PLATE, NAILED HEAD HIGH ON SAME TREE WITH 8D ALUMINUM NAILS, WITH DISTANCE AND BEARING FROM THE "W" NAIL TO THE CORNER STAMPED ON IT.

