SURVEY OF LOT 4, BY-A-RIVER MEADOWS
SEC. 23, T26S, R6W, W.M.

Surveyed for William L. Fisher by Victor M. McLind

October 1974 Scale: 1" = 100'

FILED
RECEIVED
OCT 21 1974
COUNTY SURVEYOR
DOUGLAS COUNTY, ORE.

COUNTY SURVEYOR'S FILE DATA
DO NOT REMOVE FROM OFFICE

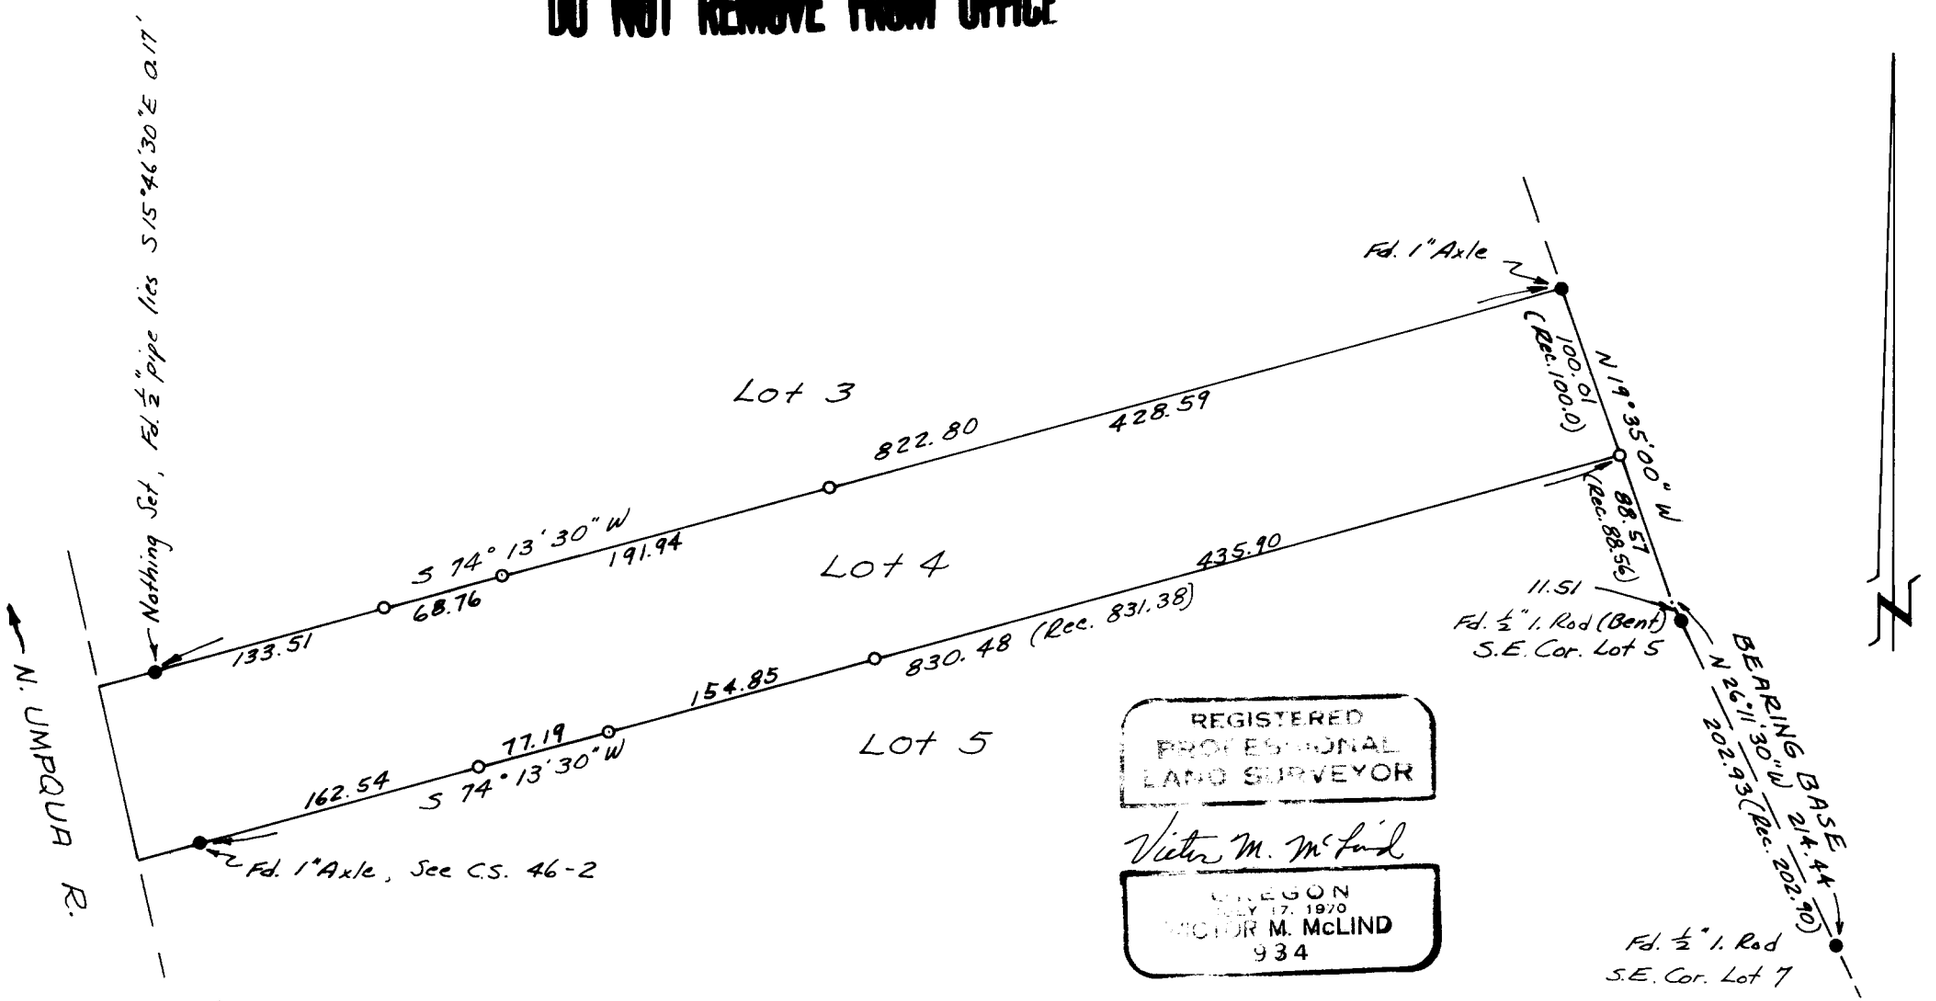

C. S. File No. 58/13