COUNTY SURVEYORS FILE DATA
DO NOT REMOVE FROM OFFICE

SURVEY TO SET PROPERTY CORS.
IN LOT 8, BLOCK 11
TERRACE PARK ADD'N.
ROSEBURG, ORE.
SECTION 19, T. 27S., R 5 W.W.M.
SURVEYED FOR JACK BUTLER
by BRUCE ROGERS
JAN., 1975
1" = 100'

FILED
RECEIVED
JAN 24 1975
COUNTY SURVEYOR
DOUGLAS COUNTY, ORE.
Bruce R. Rogers

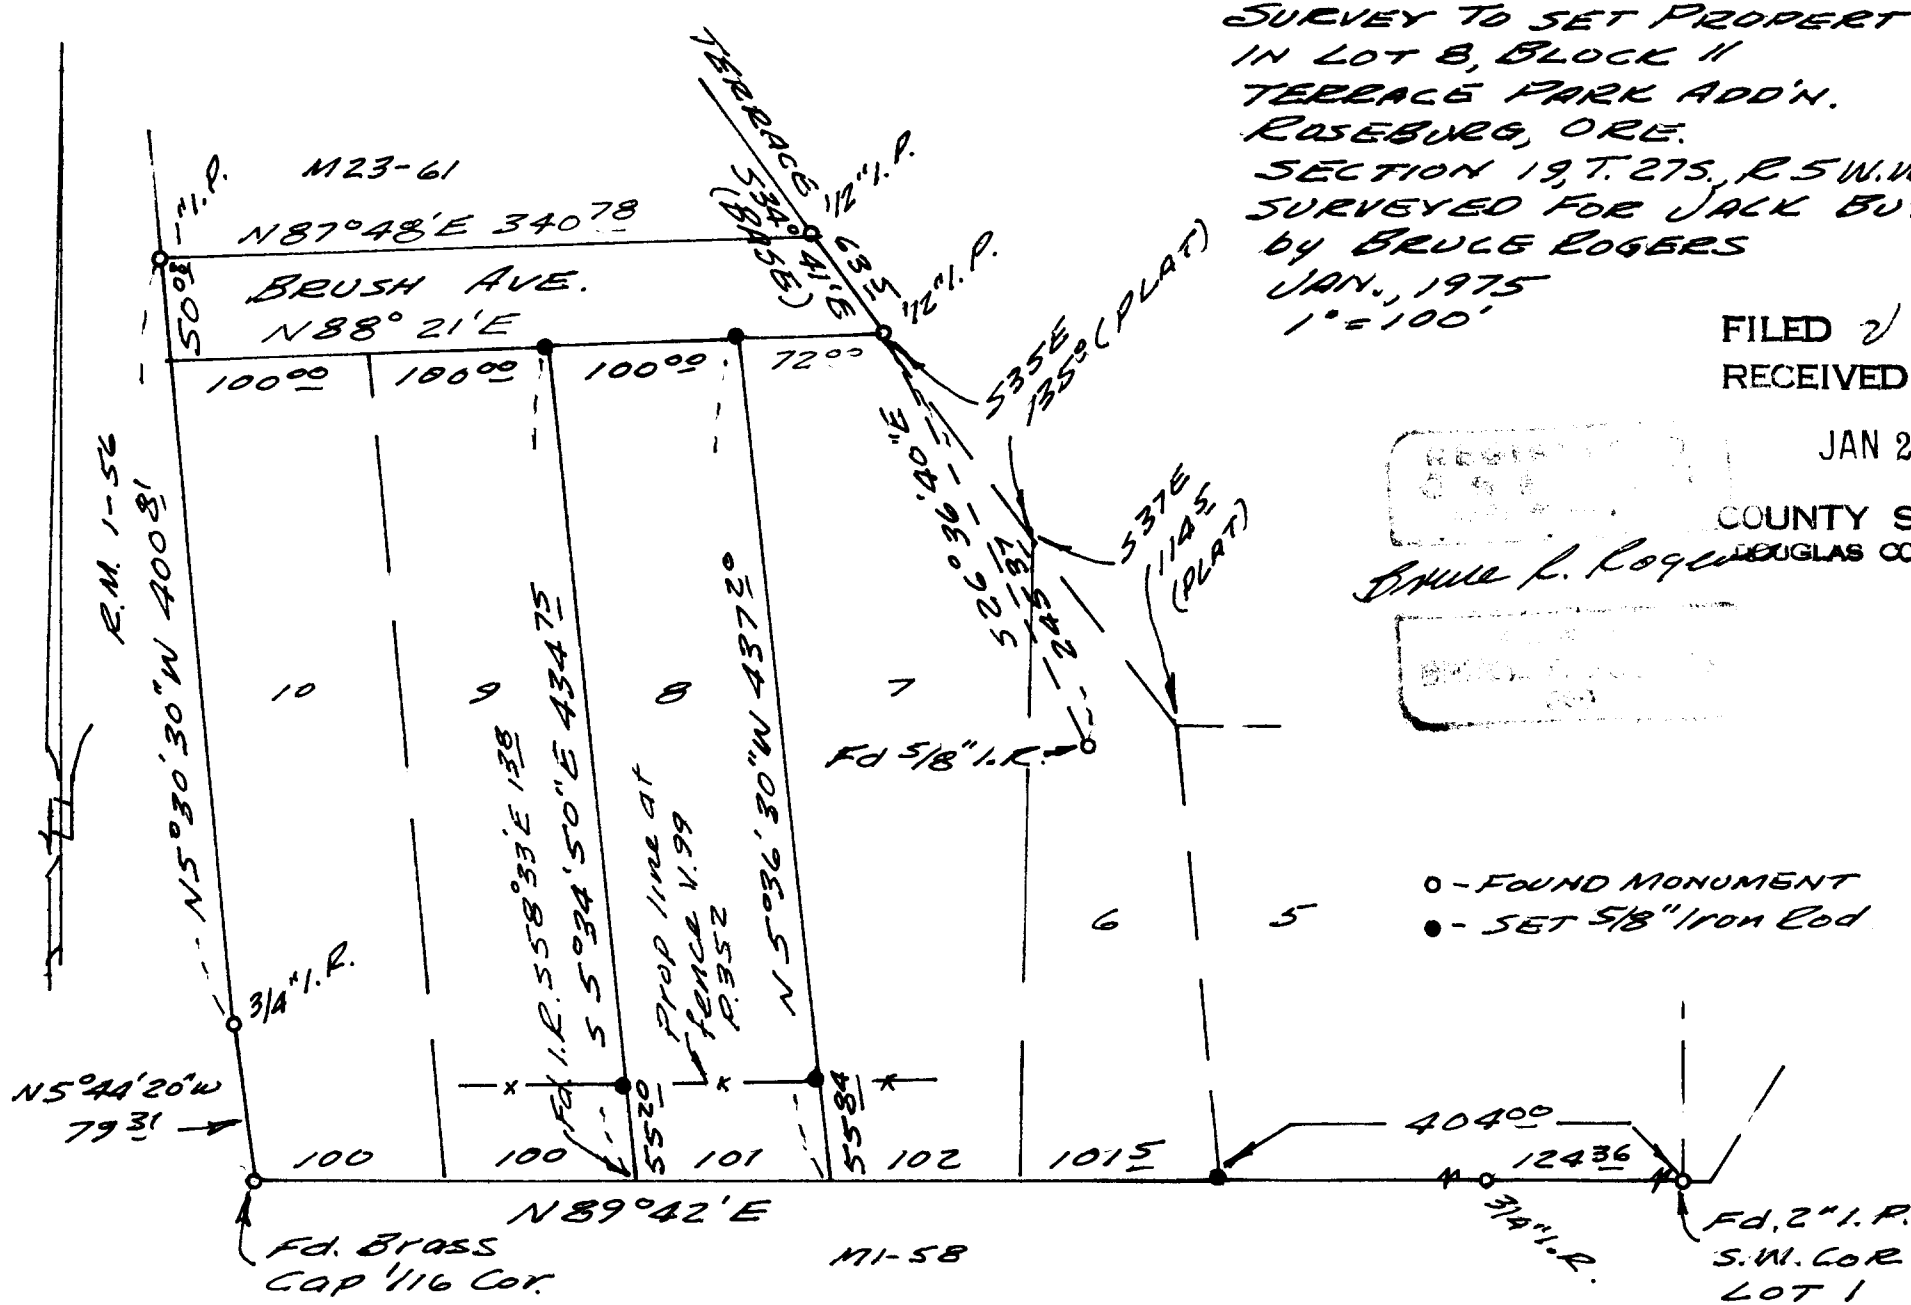

C. S. File No. 58/202