


CERTIFIED RECORD OF LAND CORNER MONUMENTATION

History of original corner establishment: August 19, 1857


ORIGINAL CORNER
 Set post to corner Sections 15/16/21/22 from which
 A Fir 18 inches diameter bears S. 10° E. 68 lks
 A Laurel 18 inches diameter bears S. 27° W. 58 lks
 A Laurel 10 inches diameter bears N. 45° E. 40 lks
 A Cedar 24 inches diameter bears N. 43° W. 31 lks

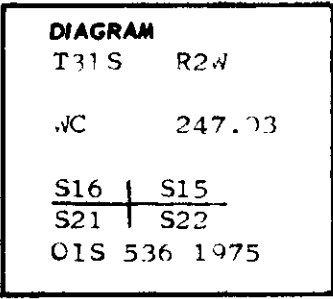

Description of corner evidence found:

I find a 1 inch galvanized iron pipe with brass cap stamped:

A 7 inch cedar bears N. 2° W. 12.0 feet scribed
 T 31S R 2W S S 16 CS (BT)
 A 8 inch cedar bears N. 47° W. 15.5 feet scribed
 T 31S R 2 W S 16 CS (BT)
 A 6 inch cedar bears S. 21° W. 15.2 feet scribed
 T 31S R 2 W visible
 A 12 inch cedar bears S. 44° W. 33.1 @ 18° 30' scribed T 31S R 2 W S 21 CS (BT)

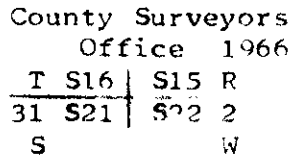


The corner lies in recent slide. I leave the County brass cap out of position. I reestablish corner position by County Surveyors bearing trees which lie outside of the slide area, a 6 inch and 12 inch cedar. Then I set the witness corner on South line of S 21 S 22 outside of slide area.

Description of monument and accessories I established to perpetuate the original location of this corner

I set a 30 inch long 2 1/2 inch diameter galvanized iron pipe 24 inches in the ground, in a mound of stone with a 3 inch brass cap stamped:

Bearing Trees:

A Cedar 7 inches diameter bears S. 56° E. 9.8 feet scribed: WC T 31S R 2 W S 22 (BT) with brass washer stamped CS 536 nailed at B. T. Blaze

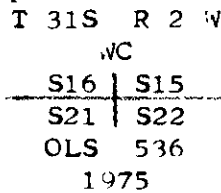

A Douglas Fir 9 inches diameter bears N. 12° W. 9.0 feet scribed: WC T 31S R 2 W S 21 (BT) with brass washer stamped CS 536 nailed at B. T. Blaze

Note: Both trees have 6 inch red band painted around the tree corner. It lies on steep East slope approximately 100 feet East of ridge top and 247 feet South of draw.

From book # 2 pag 98 Tiller Land Survey # 14 Contract #004610N

Office of Surveyors County of Douglas *Shirley R. Blyden*
 for record on the 12 day of February 1975.
Thomas D. Ingram by *Virginia A. Yates*
 (COUNTY OFFICIAL) (DEPUTY)

#156