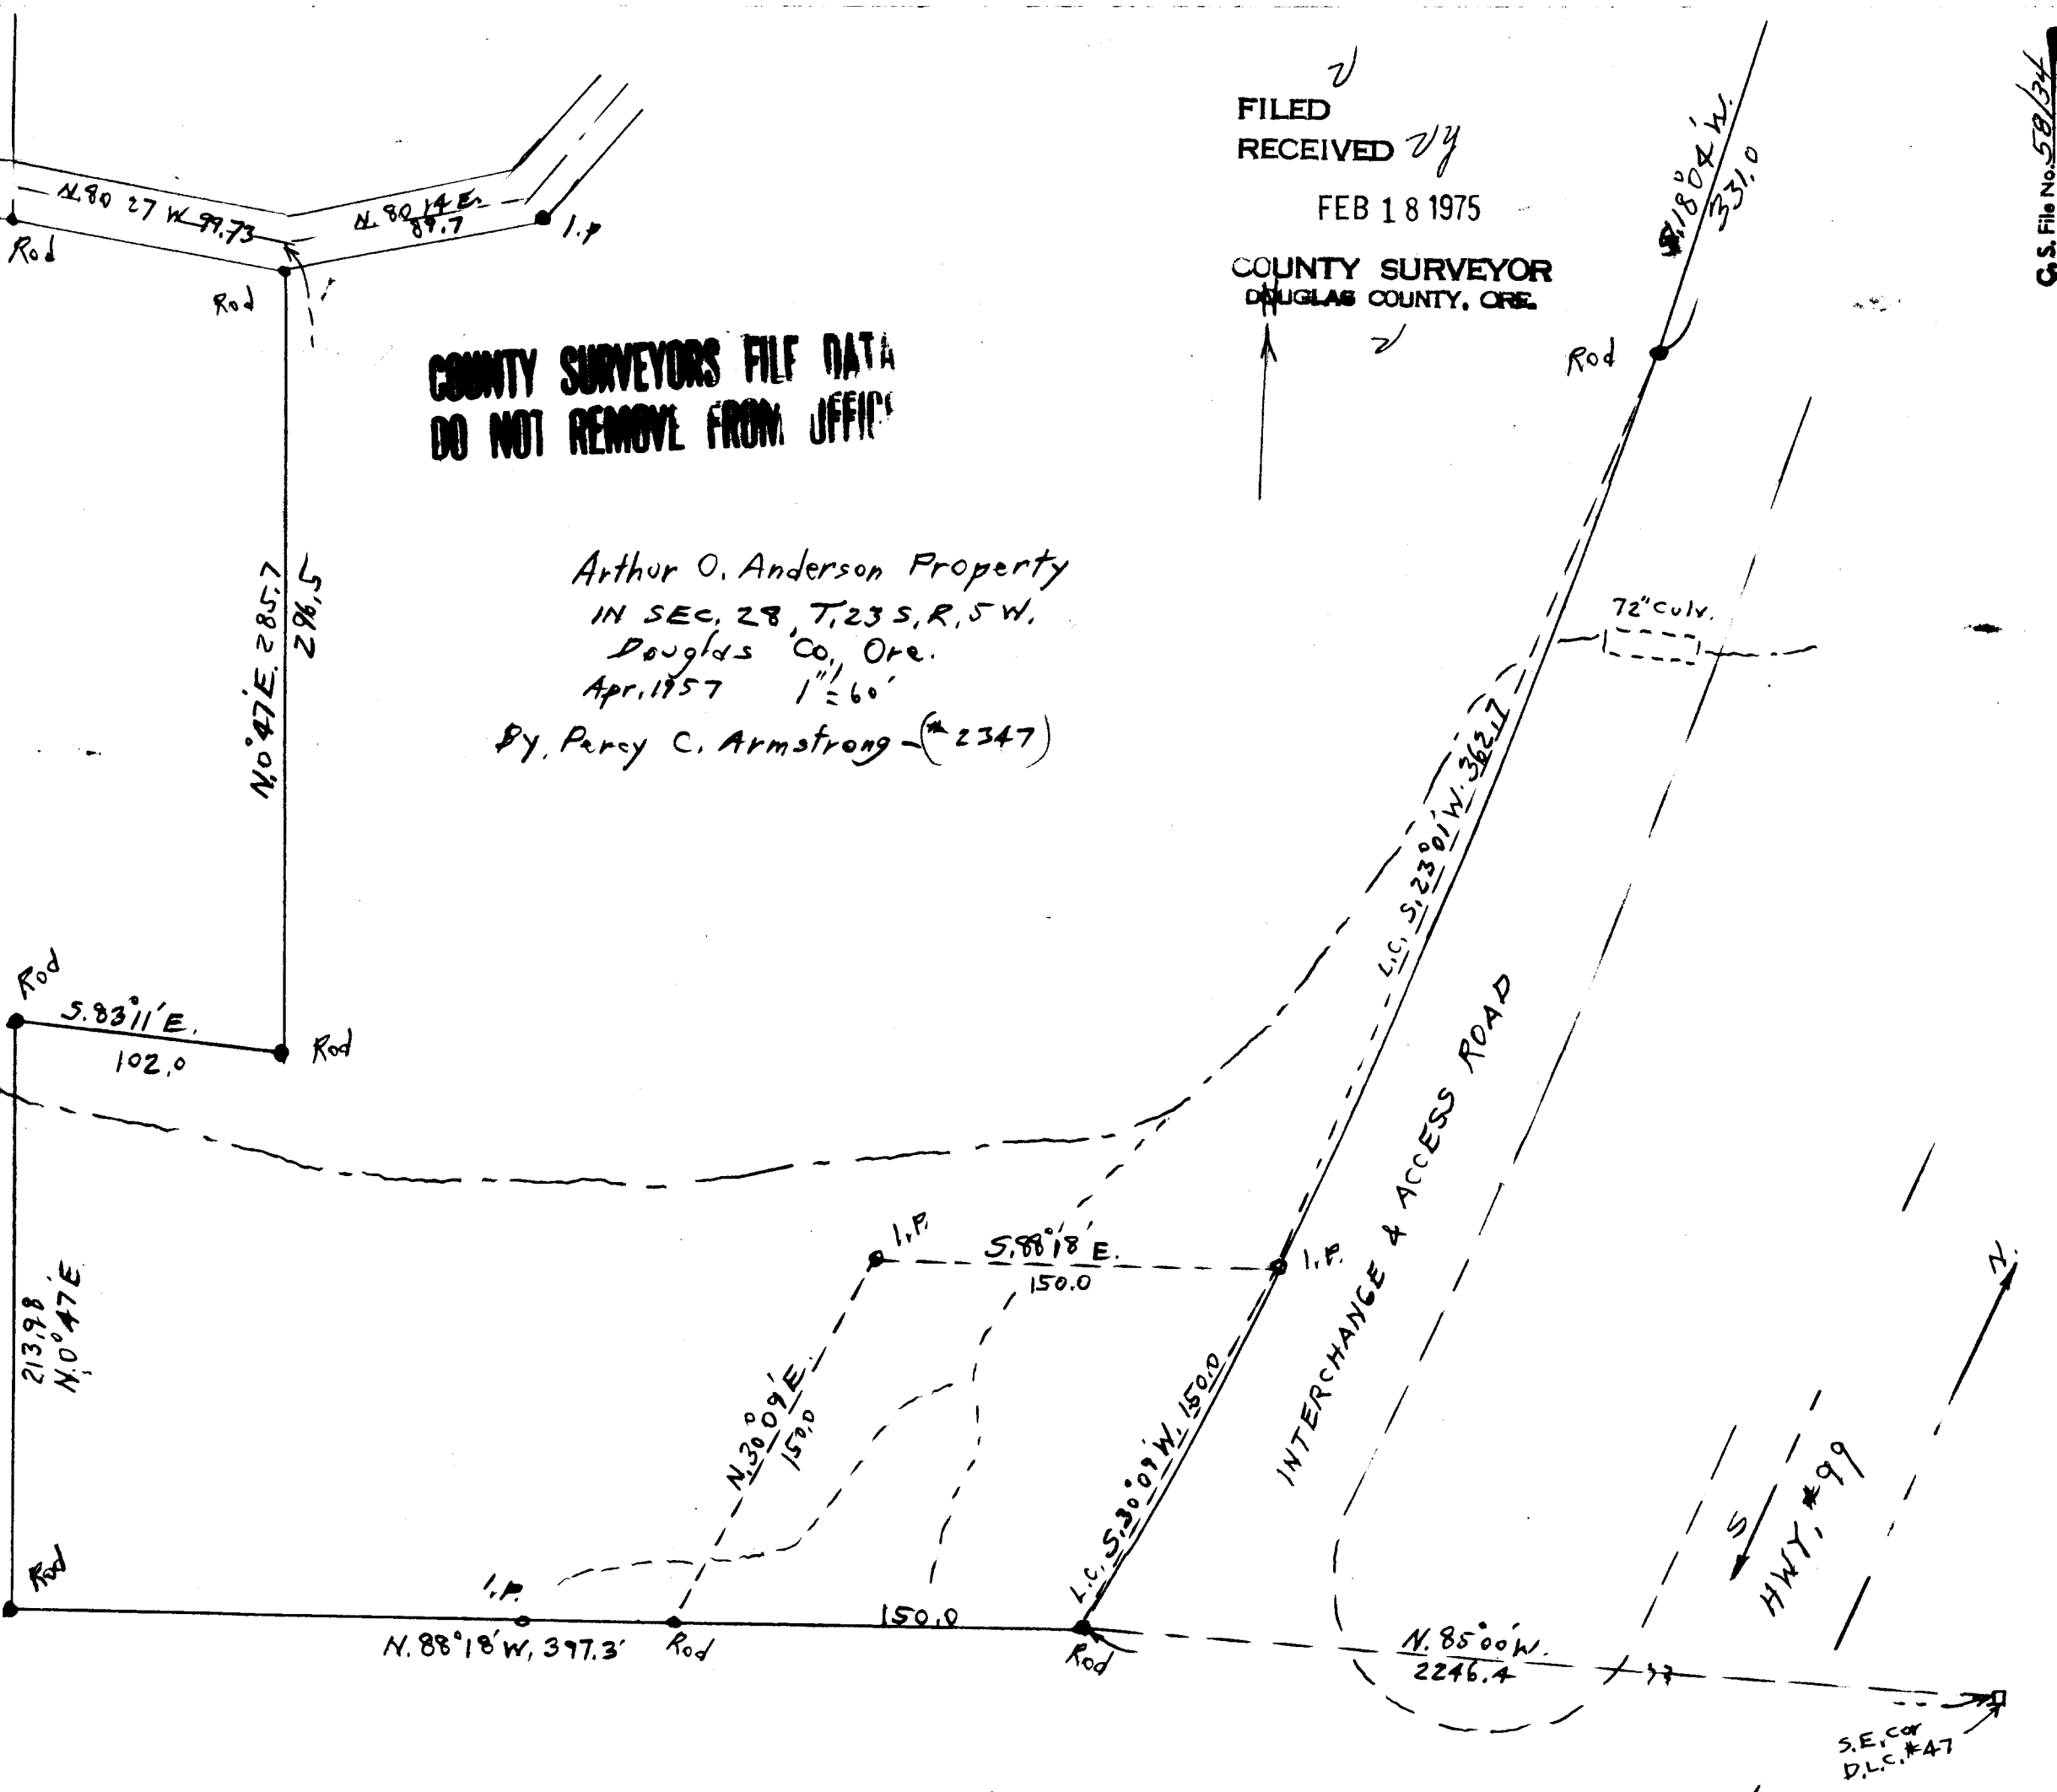

C.S. File No. 58/34

C.S. File No. 58/34 0-5049-M