Original Erickson Homesite Survey In Portions Of Section 3, T.23S., R.12W., W.M.

Coos County, Oregon

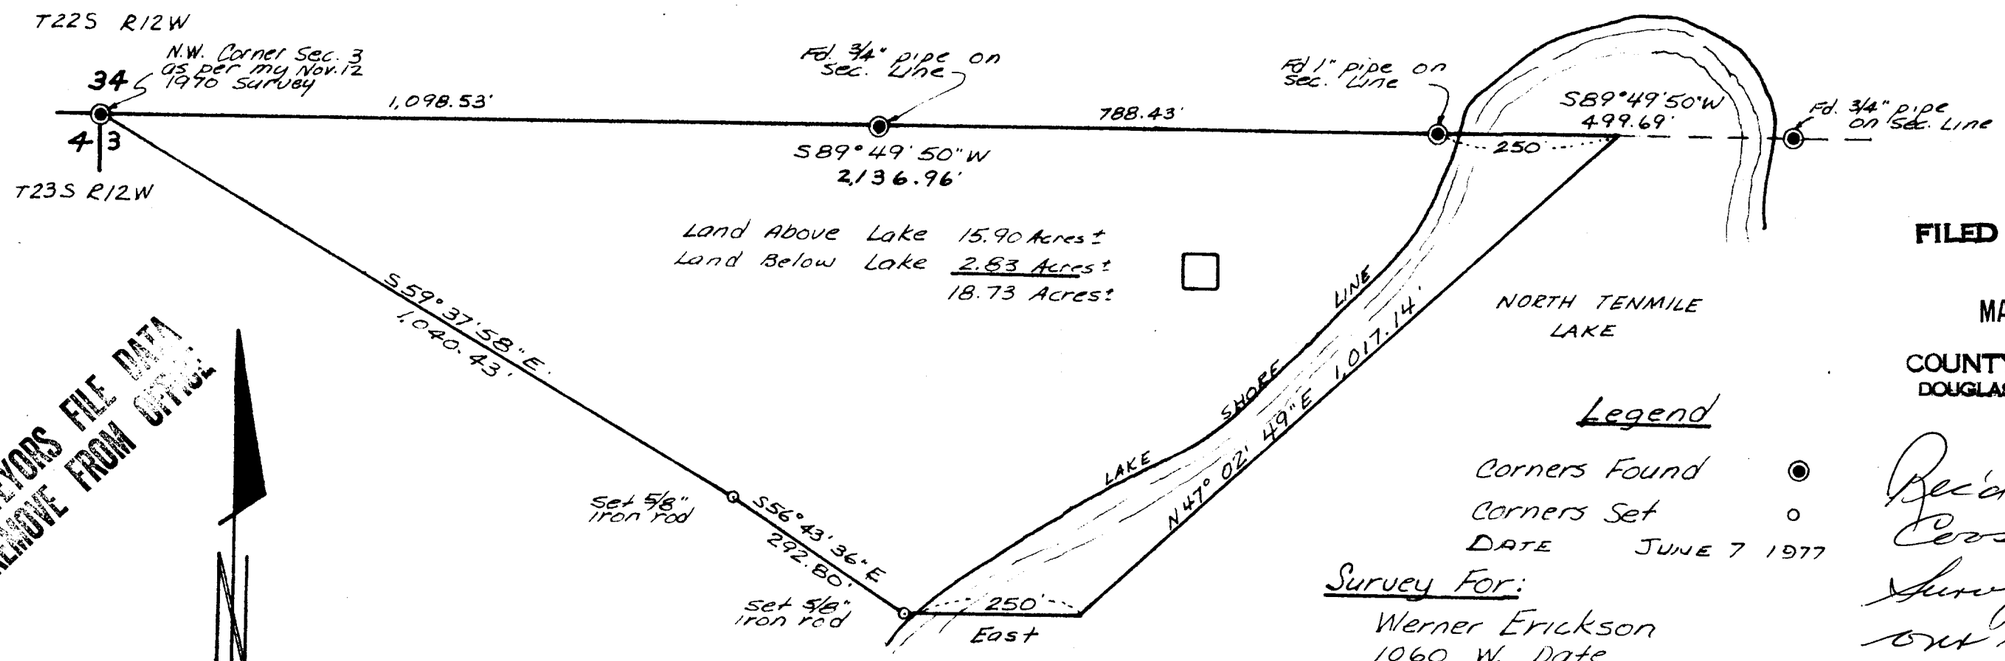

Scale 1" = 200'

Basis of bearing is my 1970 survey which was based on solar observation

COUNTY SURVEYORS FILE DATA
DO NOT REMOVE FROM OFFICE

MICRO FILMED

FILED

MAR 13 1986

COUNTY SURVEYOR
DOUGLAS COUNTY, ORE.

Legend

Corners Found ◉
Corners Set ○
DATE JUNE 7 1977

Survey For:

Werner Erickson
1060 W. Date
Coos Bay, Ore.

Survey By:

Stuntzner Engineering & Forestry
375 Park
P.O. Box 115
Coos Bay, Oregon 97420

Ronald E. Stuntz
OREGON

Rec'd from Coos Co. Surveyor per our request.

COUNTY SURVEYORS FILE DATA
DO NOT REMOVE FROM OFFICE

RECEIVED
JUN 11 1977

Filed June 15, 1977
Russell J. Black
County Surveyor

C.S. File No. 58/37-3

1082