SURVEY TO SET PROPERTY CORNERS
IN LOT 4 TODD BUILDING COMPANY SUBDIVISION NO.2
SECTION ~~17~~ 20, T.27S. R.5W.W.M.

8/6/81 vf APRIL 1975 SCALE: 1"=100'

FOR: DOYCE STONE

BY: BAUGHMAN SURVEYING SERVICE

FILED ✓
RECEIVED ✓✓
APR 30 1975
COUNTY SURVEYOR
DOUGLAS COUNTY, ORE.
✓

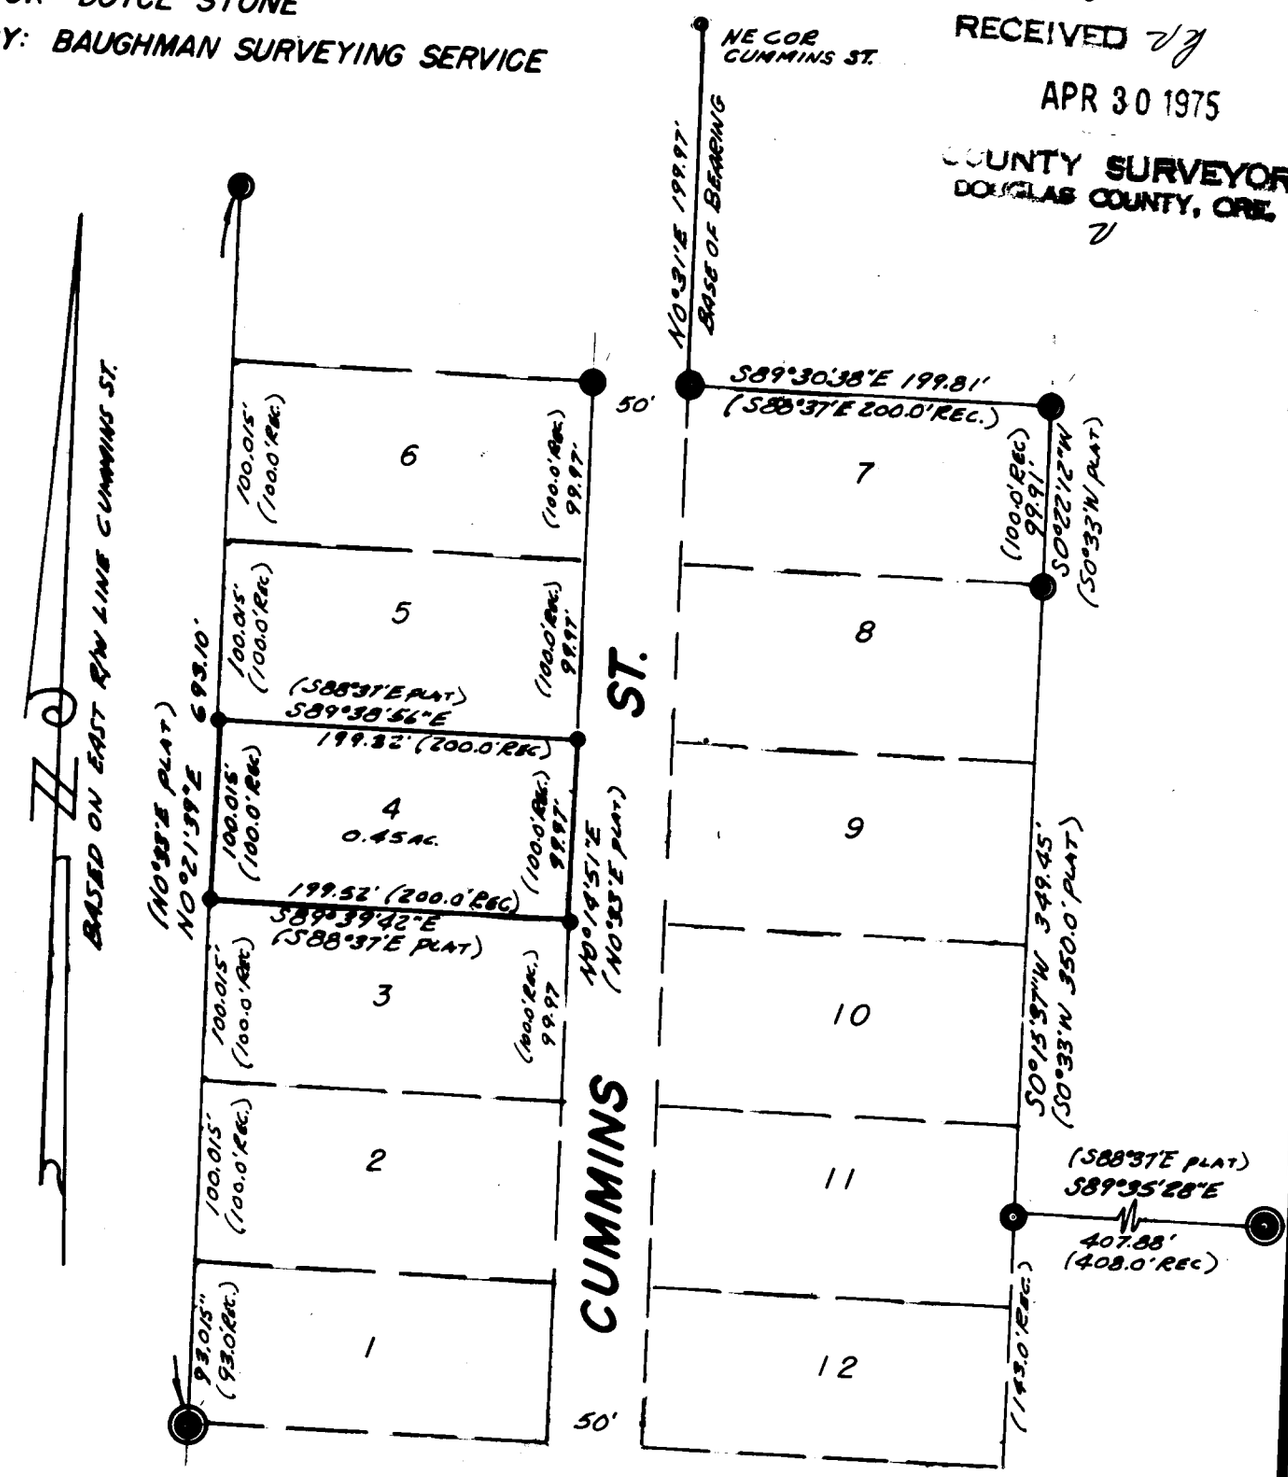

LEGEND

- Found 1/2" iron rod
- Set 1/2" iron rod
- Found 5/8" iron rod
- Found 1" iron pipe
- Found 3/4" iron pipe
- Found 2" iron pipe
- Found 1-1/2" iron pipe

COUNTY SURVEYORS FILE COPY
DO NOT REMOVE FROM OFFICE

REGISTERED PROFESSIONAL LAND SURVEYOR

Glenn S. Baughman

OREGON
JULY 14, 1961
GLENN S. BAUGHMAN
536

C.S. File No. 58/49-2