SURVEY TO SET PROPERTY CORNERS
IN SECTION 1, T 29 S, R 6 W, W.M.
Surveyed for Bill Shelton by Victor M. McLind
April 1976 Scale: 1" = 100'

FILED
RECEIVED

COUNTY SURVEYOR
COUNTY, ORE.

● ~ Indicates Found ¾" Iron Pipe
○ ~ Indicates Set ⅝" x 30" Iron Rod

COUNTY SURVEYORS FILE
DO NOT REMOVE FROM OFFICE

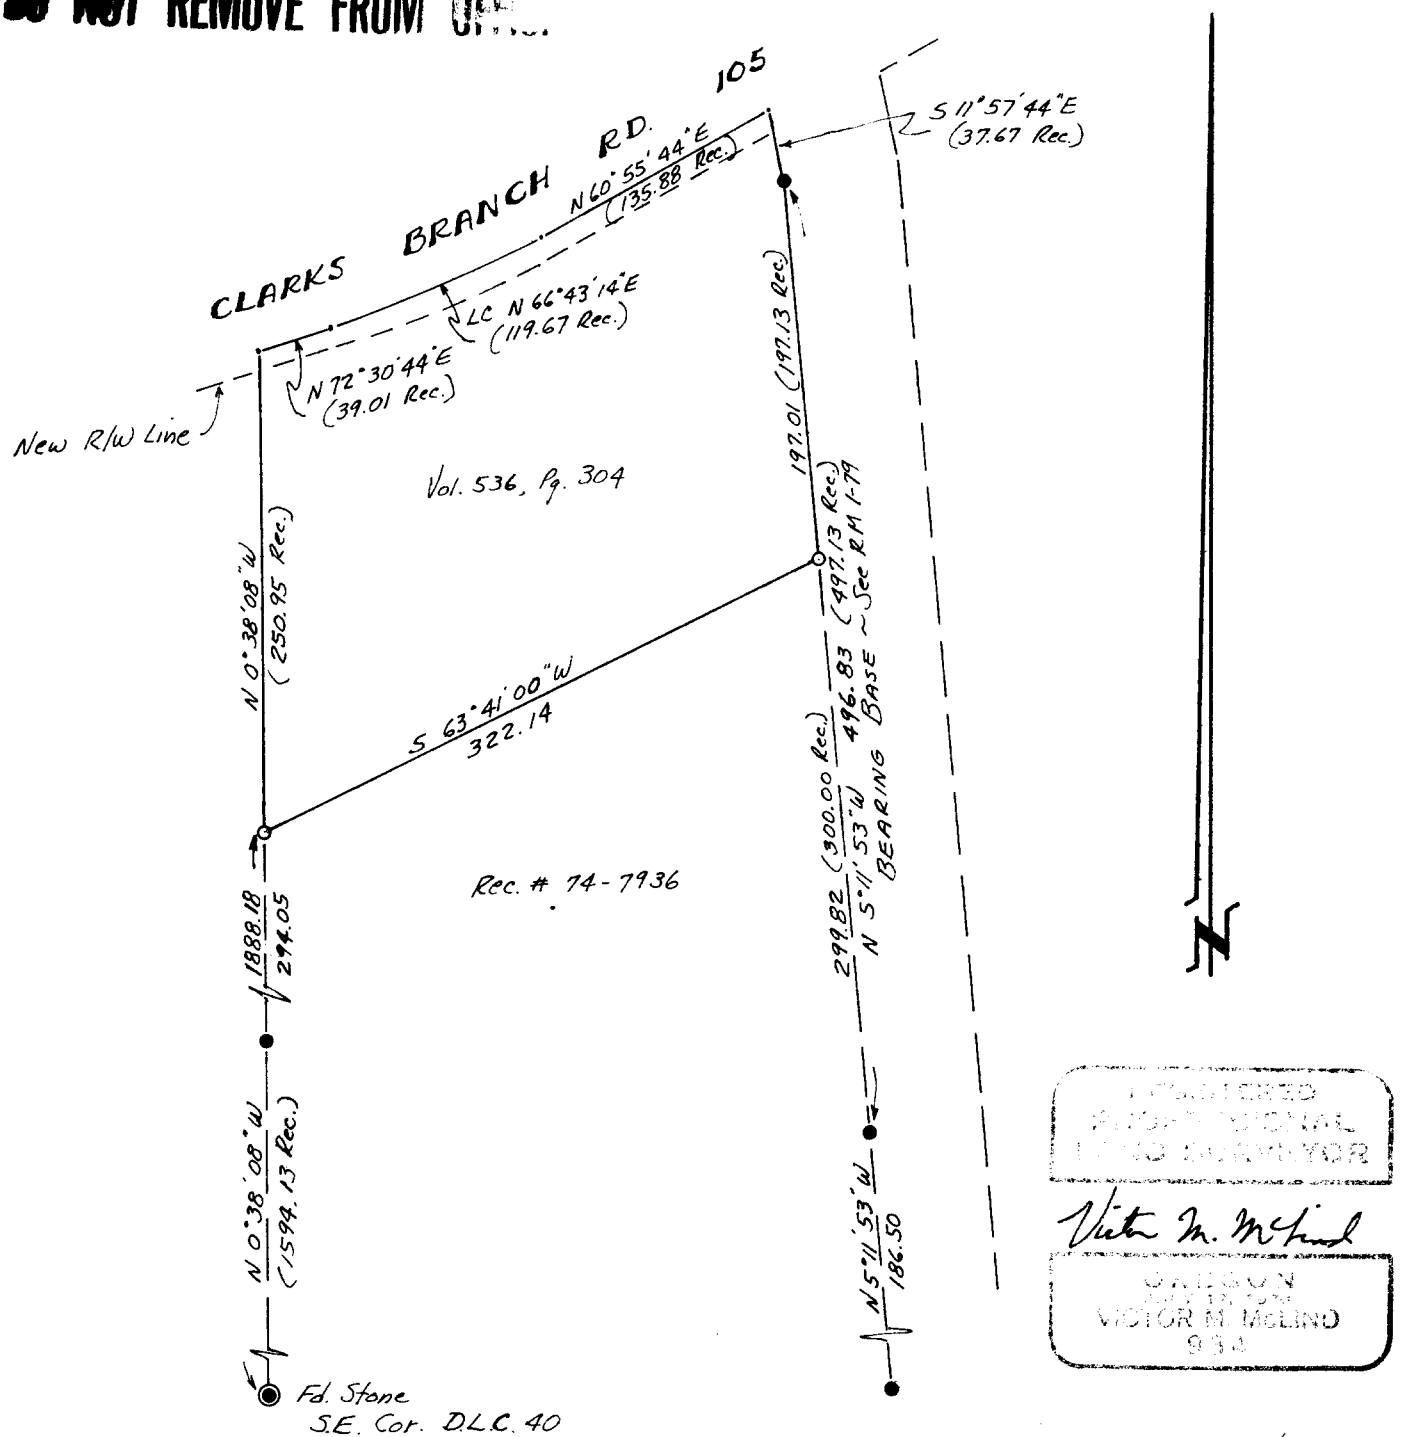

REGISTERED
PROFESSIONAL
LAND SURVEYOR

Victor M. McLind

OREGON
JULY 19, 1968
VICTOR M. McLIND
954

S. File No. 58/50-2