FILED
RECEIVED
SEP 15 1975
COUNTY SURVEYOR
DOUGLAS COUNTY, ORE.

SURVEY TO SET PROPERTY CORNERS
LOTS 8 & 9 BLOCK 78, SUB. "A" KINNEY'S IMPROVED PLAT
LYING IN SECTION 18 T27S R5W W.M.

SURVEYED FOR KIN LANCASTER SEP. 1975
BY BAUGHMAN SURVEYING SERVICE SCALE 1"=40'

COUNTY SURVEYORS FILE DATA
DO NOT REMOVE FROM OFFICE

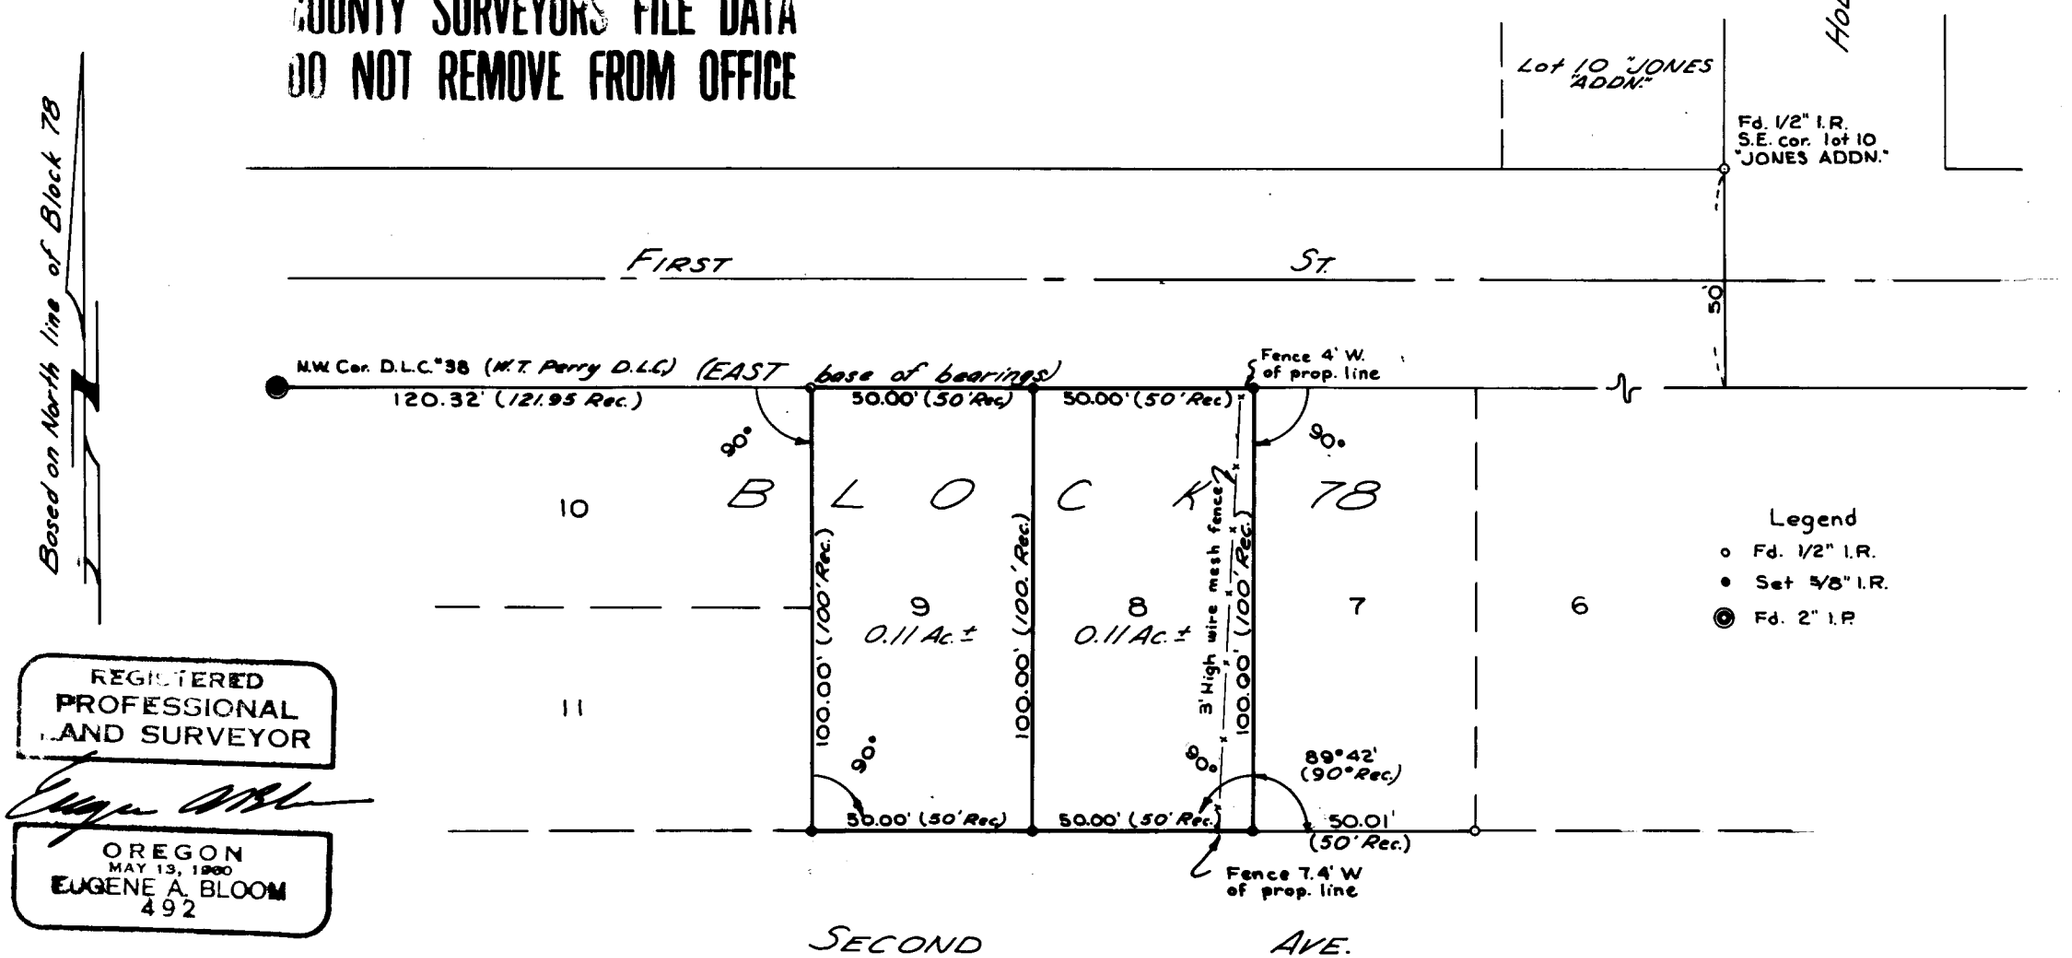

REGISTERED PROFESSIONAL LAND SURVEYOR
OREGON
MAY 13, 1960
EUGENE A. BLOOM
492

35247

C. S. File No. 58/61-3