FILED
RECEIVED

Survey in

Sec. 22, T25S, R5W, W.M.
Lot 7, Block 3, Sutherlin Land & Water Co., Plat IV

For: H.L. Wahl

By: BHW Eng. & Surveying, Inc.

Scale: 1" = 100 Date: Sept. 1975

COUNTY SURVEYORS FILE DR
DO NOT REMOVE FROM OFFI

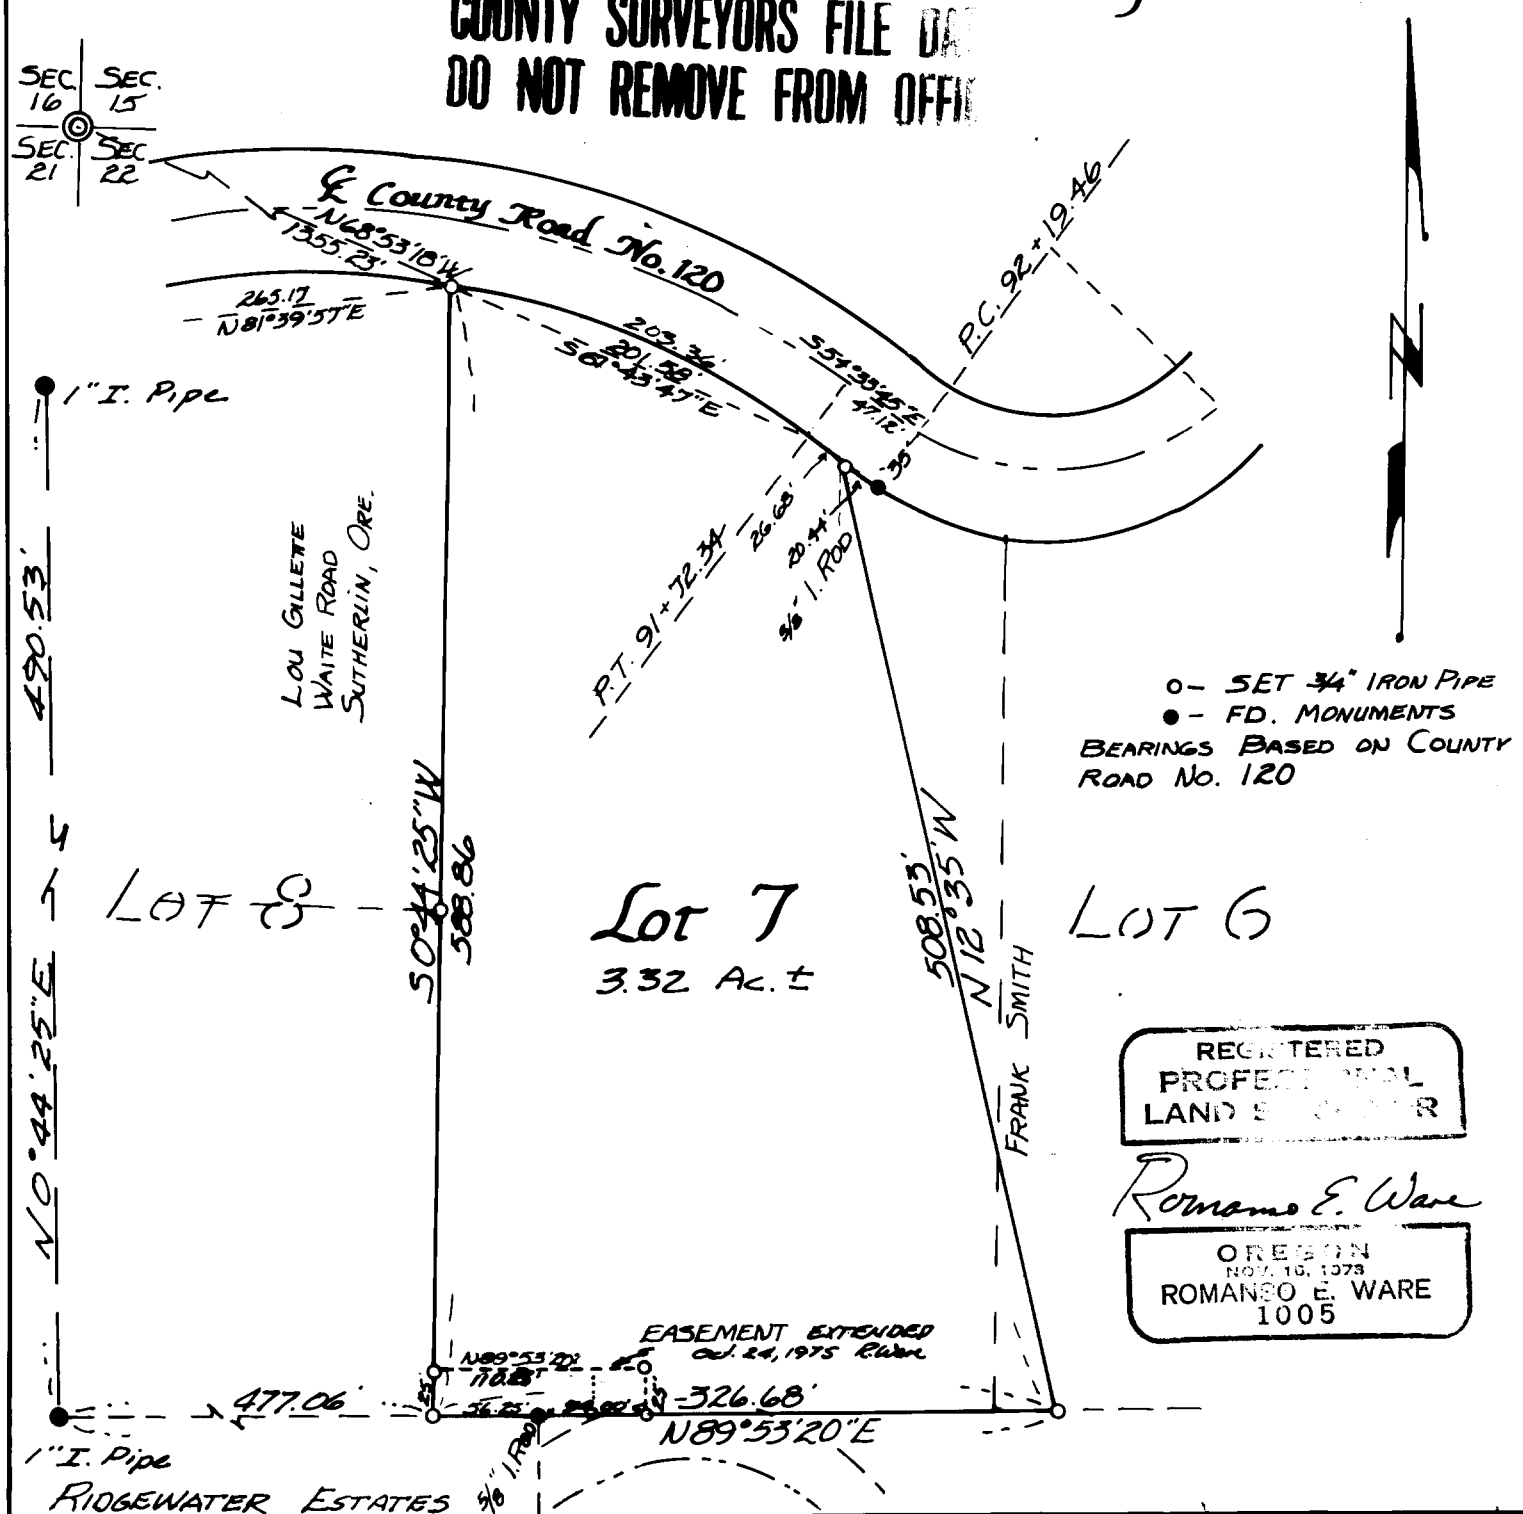

REGISTERED PROFESSIONAL LAND SURVEYOR

Romano E. Ware

OREGON
NOV. 16, 1973
ROMANO E. WARE
1005

C.S. File 58/166-2