(9)

FILED
RECEIVED

OCT 12 1977

COUNTY SURVEYOR
DOUGLAS COUNTY, ORE.

SECT. 19, T.22S., R.7W. W.M.

Marty Morgan Elkton, Ore.
1975

N.W. Cor.
James Louins DLC #39
T.22S., R.7W. W.M.

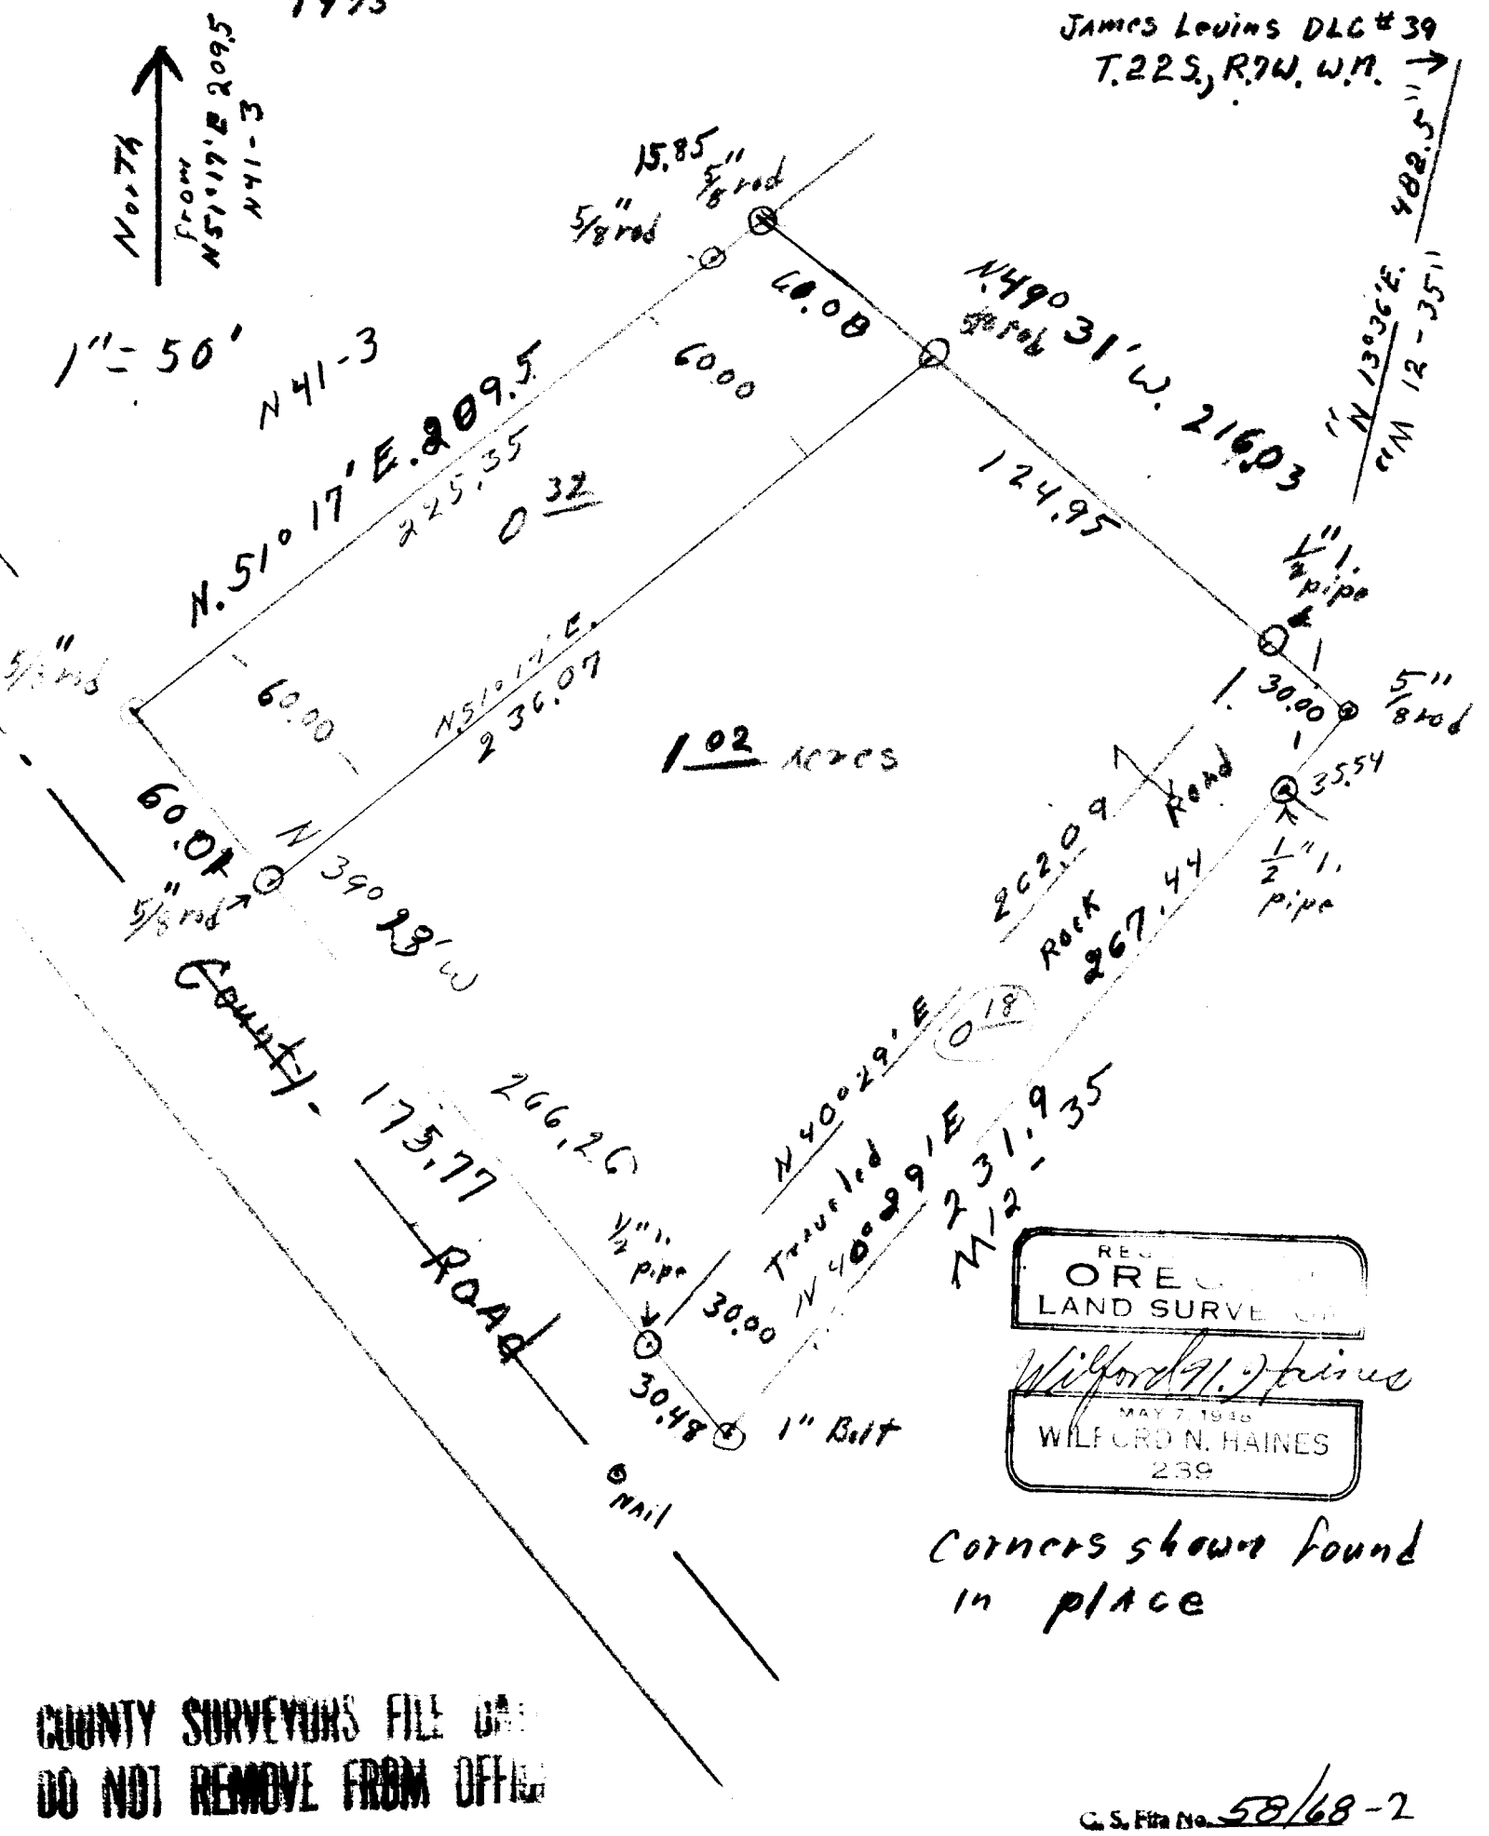

REG. OREGON LAND SURVEYOR
Wilford N. Haines
MAY 7, 1968
WILFORD N. HAINES
239

Corners shown found in place

COUNTY SURVEYORS FILE ONLY
DO NOT REMOVE FROM OFFICE

C. S. File No. 58/68-2