FILED
RECEIVED
NOV 5 1975
COUNTY SURVEYOR
DOUGLAS COUNTY, ORE.

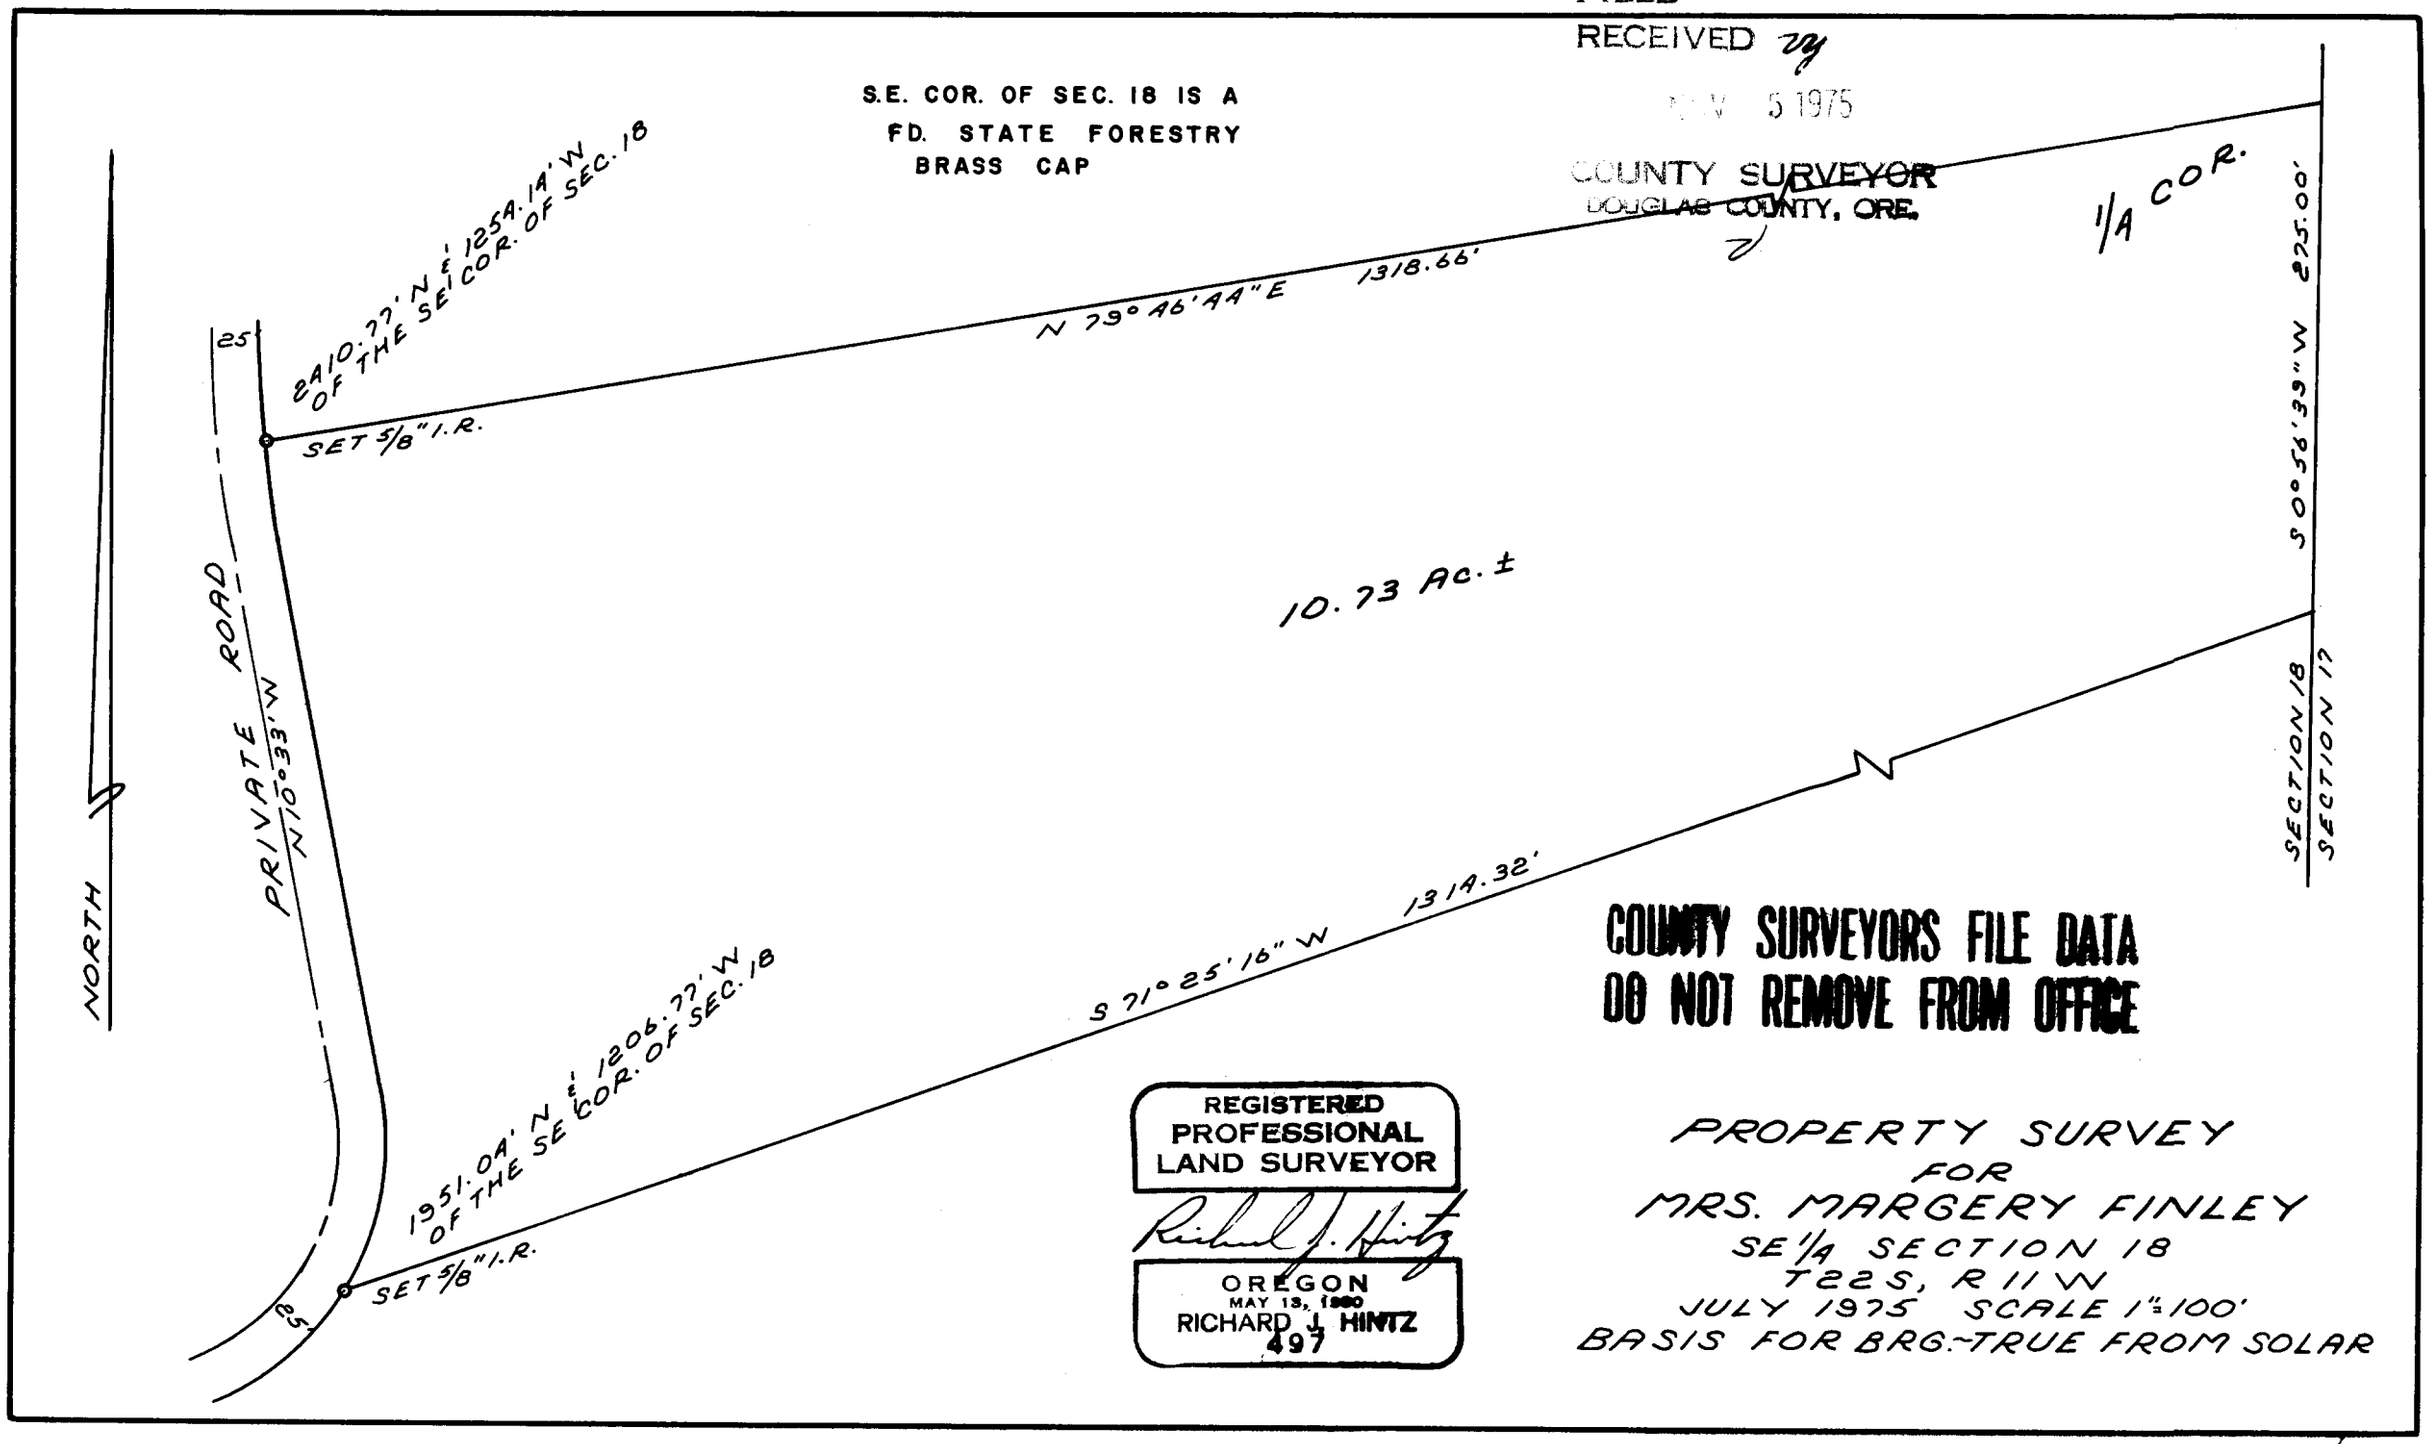

COUNTY SURVEYORS FILE DATA
DO NOT REMOVE FROM OFFICE

REGISTERED
PROFESSIONAL
LAND SURVEYOR
Richard J. Hintz
OREGON
MAY 13, 1980
RICHARD J. HINTZ
497

PROPERTY SURVEY
FOR
MRS. MARGERY FINLEY
SE 1/4 SECTION 18
T22S, R11W
JULY 1975 SCALE 1"=100'
BASIS FOR BRG.-TRUE FROM SOLAR

C. S. File No. 58/73-2