


SCALE: 1"=200'

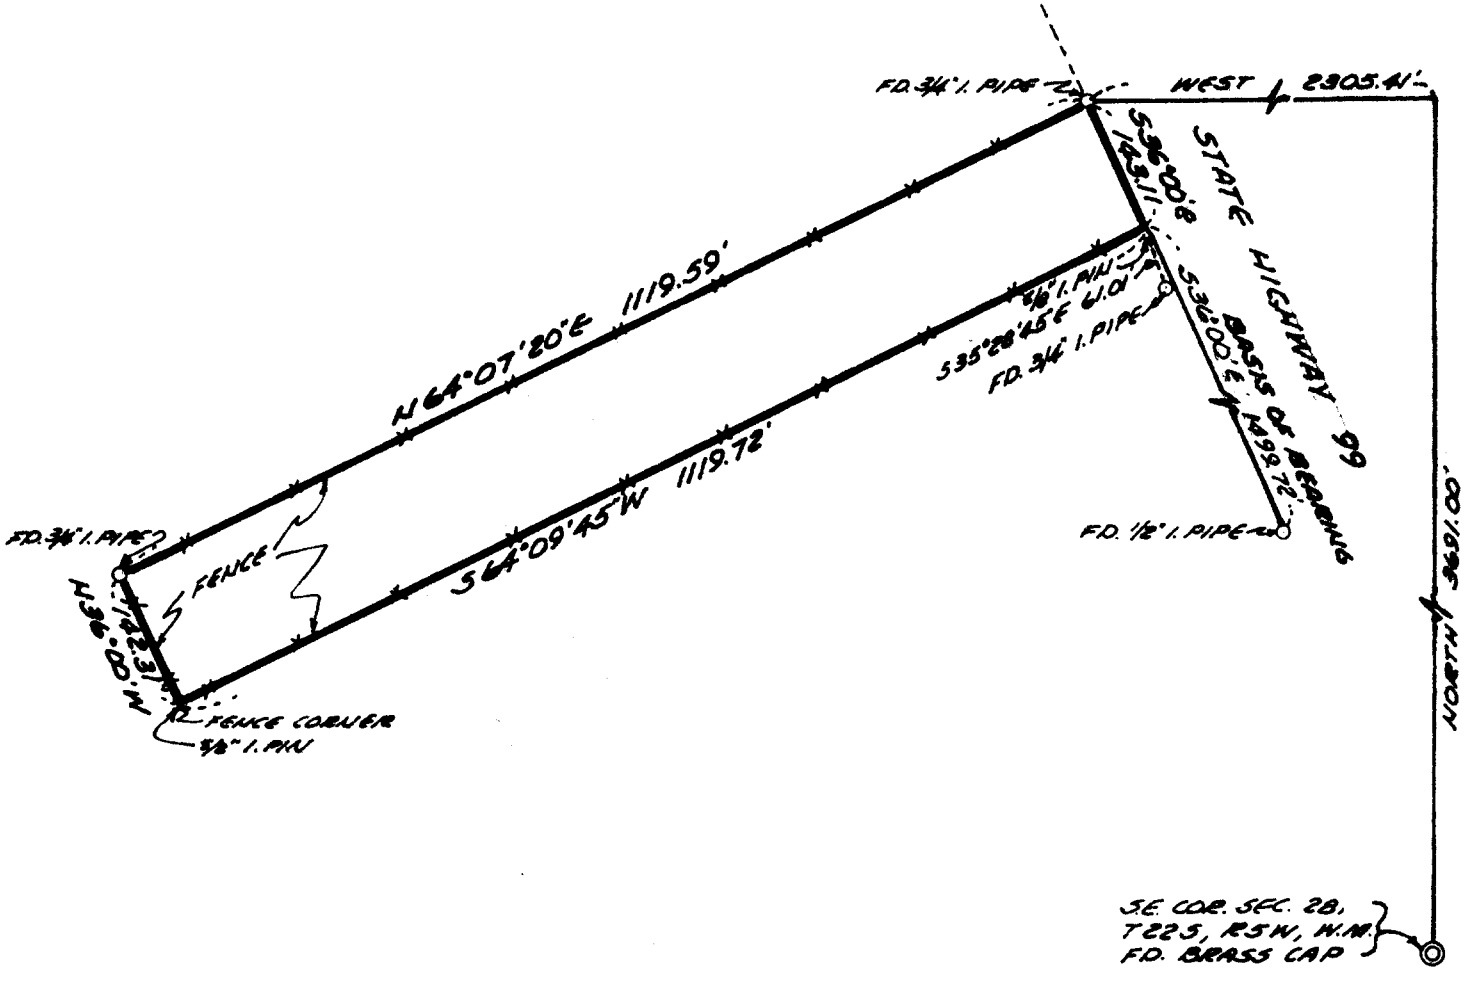

<b>LEE C. PLANTS, PROFESSIONAL ENGINEER</b> 54 CENTENNIAL LOOP; EUGENE, OREGON (503) 686-9211 510 KINGWOOD STREET; FLORENCE, OREGON (503) 997-8411	
PROJECT	PROPERTY SURVEY
CLIENT	DARRELL PAYNE
LOCATION	SEC. 28, T. 22 S., R. 5 W., N.M. DOUGLAS COUNTY, OREGON
DRAWN BY: R.M.W.	DECEMBER 12, 1975 REVISED MAY 7, 1976

