REGISTERED
OREGON
LAND SURVEYOR

JULY 12, 1968
WILLIAM J RUPPERT
866

FILED mg
RECEIVED

FIELD SURVEY OF OCCUPANCY FOR J A. ELLISON

SEC 24 T. 29 S., R 5 W., WM.

SURVEYOR
COUNTY, ORE.

COUNTY SURVEYORS FILE DATA
DO NOT REMOVE FROM OFFICE

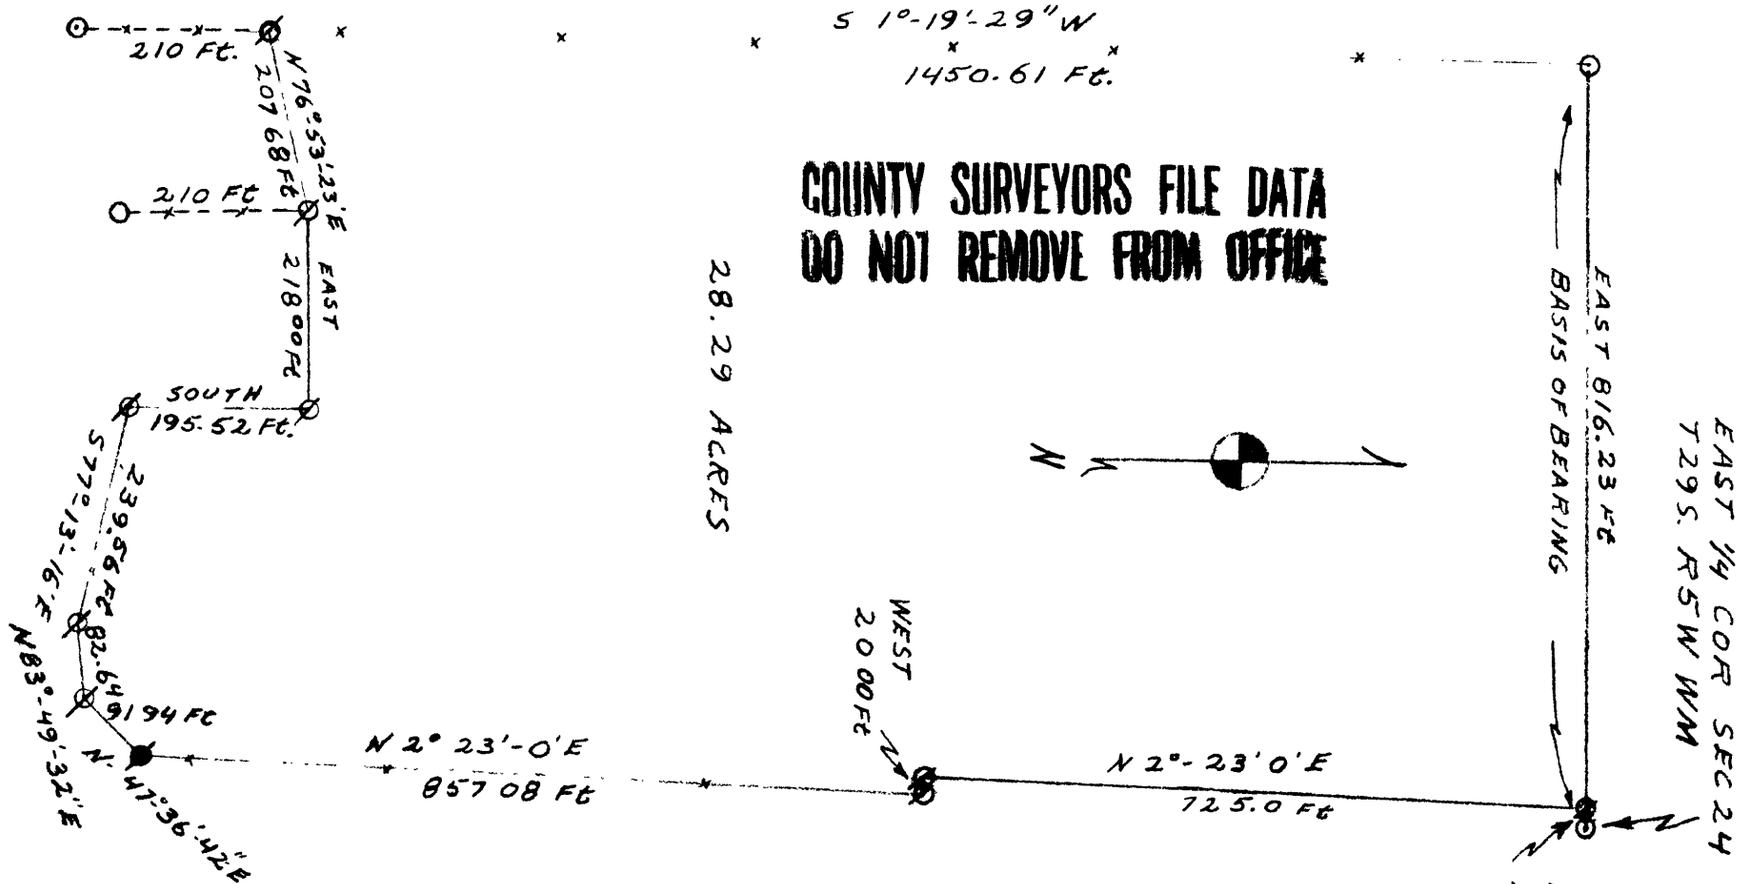

UMPQUA RESEARCH CO
MYRTLE CREEK, OREGON
JAN 1976 BY BILL RUPPERT

SCALE 1" = 200 Ft

- FOUND 3/4" IRON PIPE
- SET 3/4" IRON PIPE
- SET 1/2" IRON PIPE

E-9-1/85