C. S. File No. 58/99-2

COUNTY SURVEYORS FILE DATA
DO NOT REMOVE FROM OFFICE

FILED
RECEIVED
APR 23 1976
COUNTY SURVEYOR
DOUGLAS COUNTY, ORE.

Survey of Lots 2 & 3, Block 3, Wharton Acres in Section 13, Township 27 South, Range 6 West, Willamette Meridian.
Surveyed for Stevenson Realty by Don E. Garrett
April 1976
Scale 1" Equals 50'

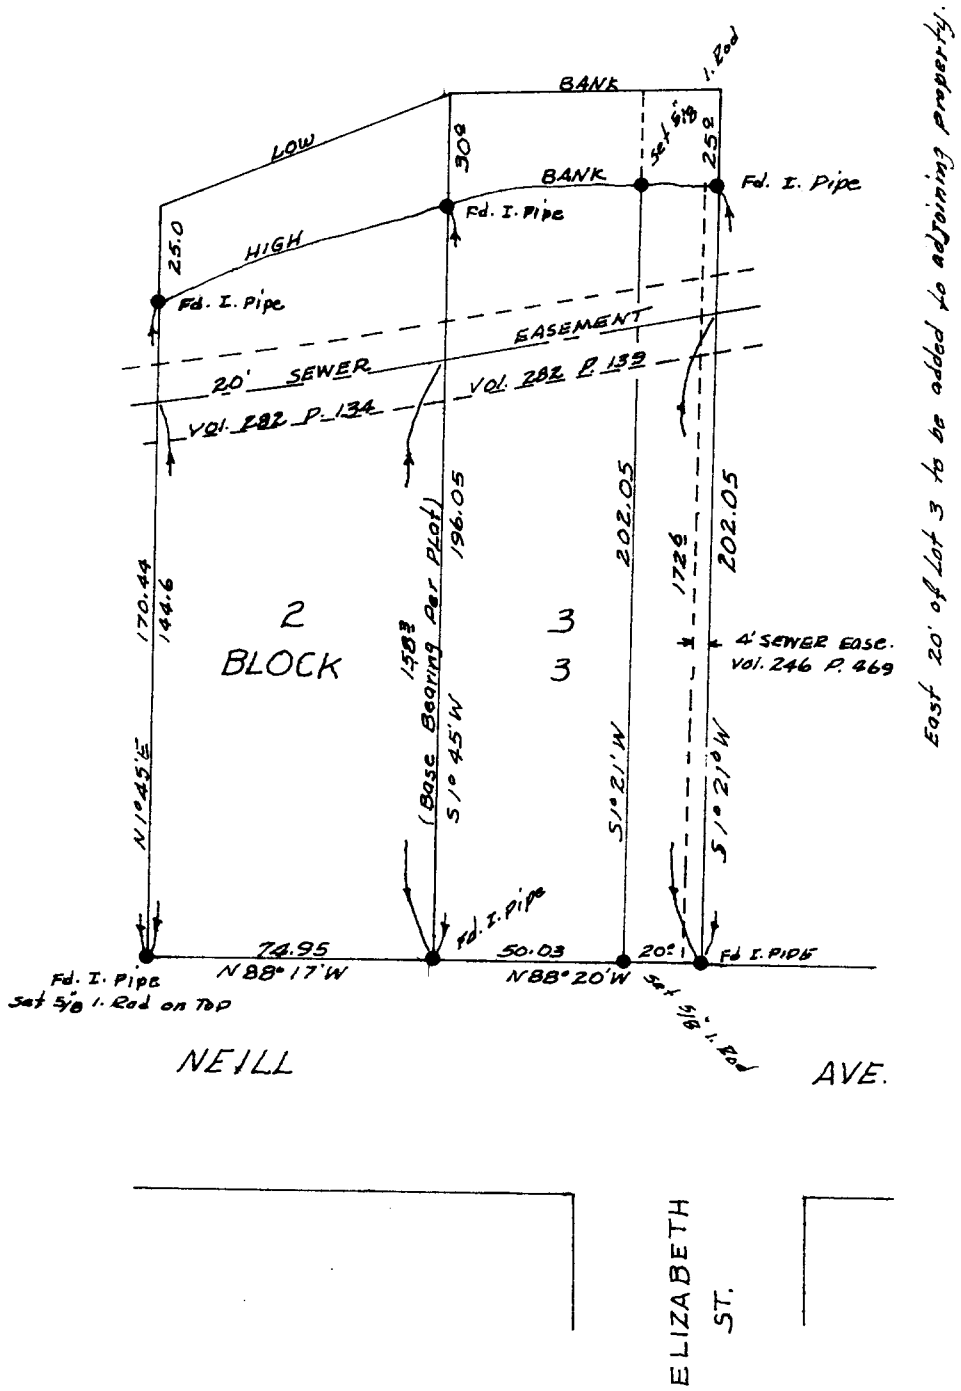

REGISTERED
PROFESSIONAL
LAND SURVEYOR
OREGON
JULY 14, 1967
DON E. GARRETT
544

C. S. File No. 58/99-2