C.S. File No. C.S. 58/100

SKETCH OF THE W½ NORTH LINE SECTION 6, T.26S. R.2W. W.M.

FOR: WEYERHAEUSER COMPANY

BY: BAUGHMAN SURVEYING SERVICE

MARCH 1976

SCALE: 1" = 500'

FILED ✓ RECEIVED G.L.T.

APR 12 1976

COUNTY SURVEYOR
DOUGLAS COUNTY, ORE.

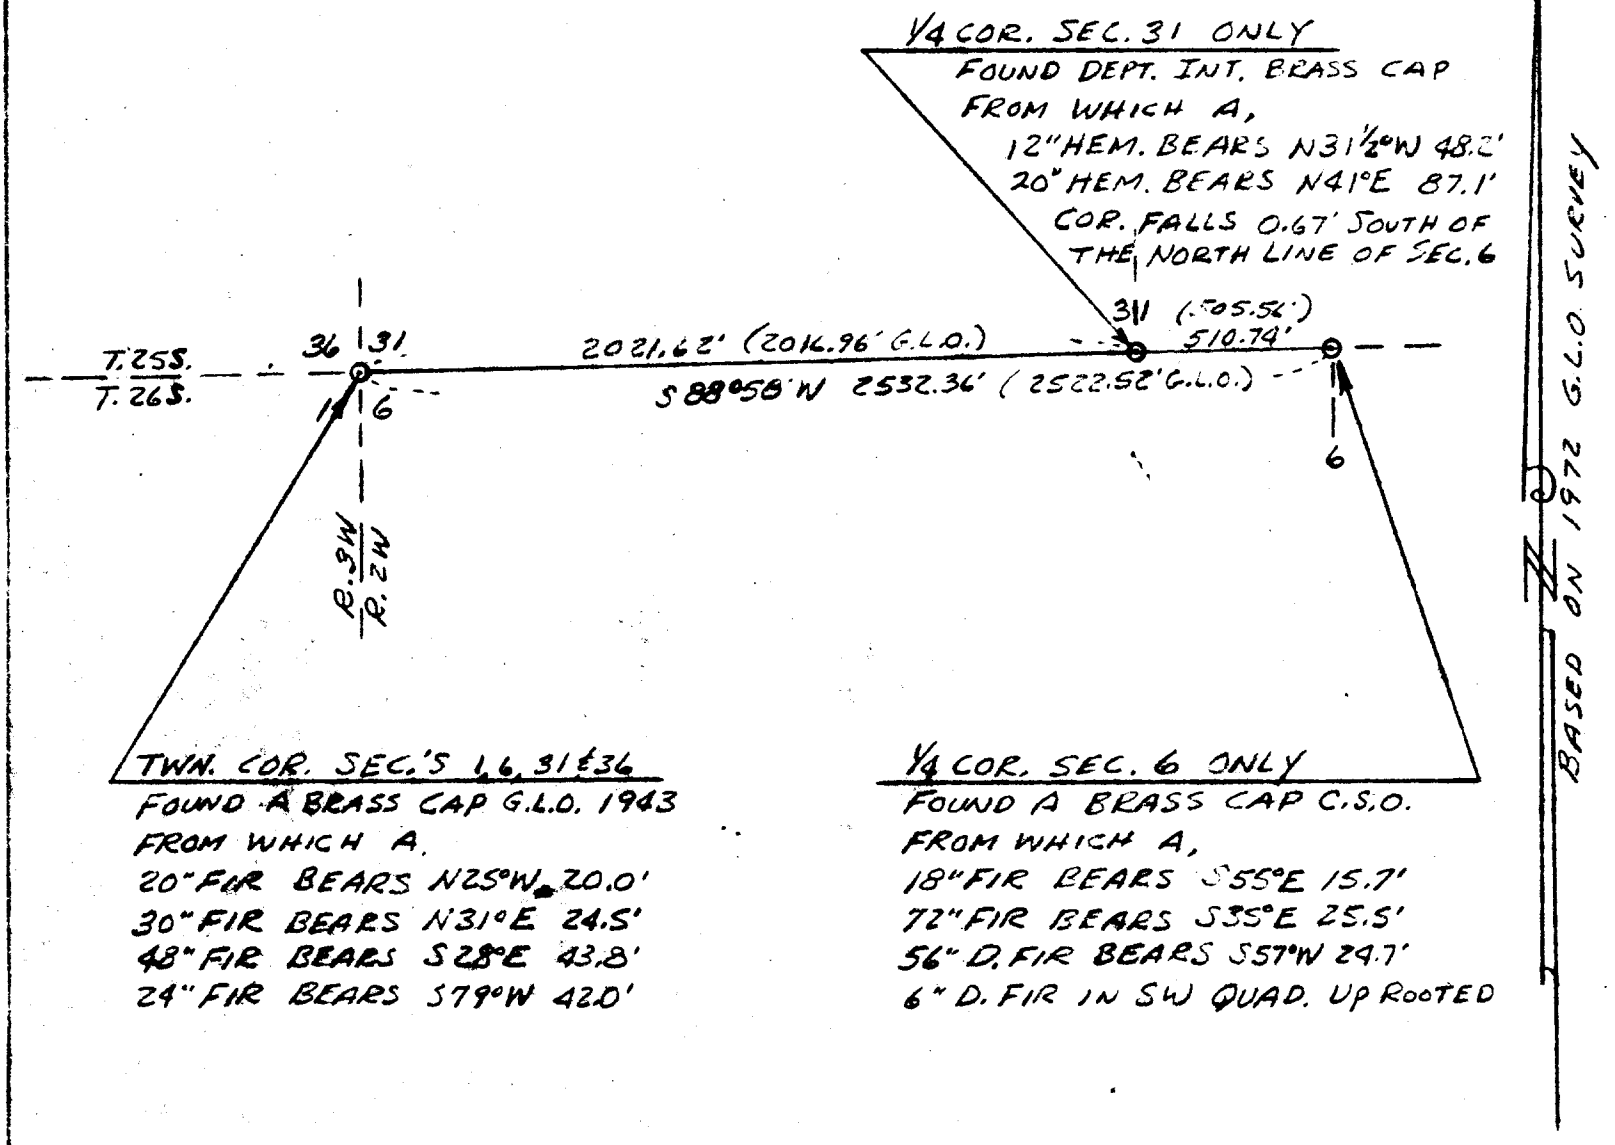

COUNTY SURVEYORS FILE DATA
DO NOT REMOVE FROM OFFICE

36303

C. S. File No. C.S. 58/100