C.S. File No. C.S. 58/126

SURVEY FOR DESCRIPTION

IN SEC. 24, T.30S. R.6W.W.M. — FOR: HOWARD LUNDERSTADT

BY: BAUGHMAN SURVEYING SERVICE

JULY 1976

SCALE: 1" = 100'

COUNTY SURVEYORS FILE DATA
DO NOT REMOVE FROM OFFICE

FILED
RECEIVED
AUG 3 1976
COUNTY SURVEYOR
DOUGLAS COUNTY, ORE.

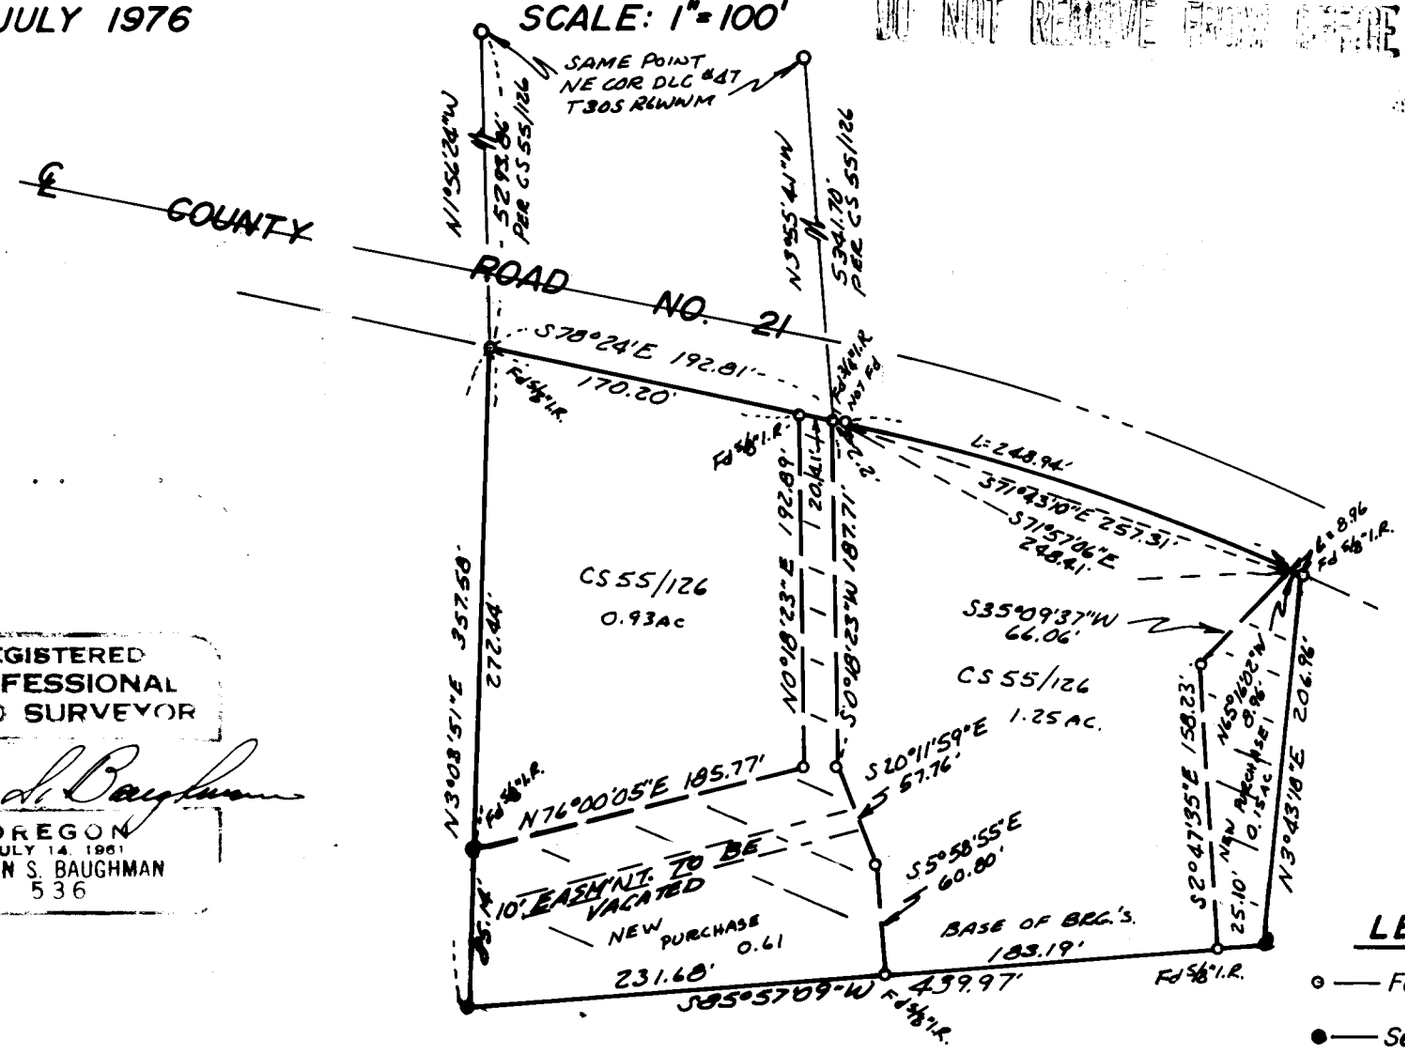

REGISTERED
PROFESSIONAL
LAND SURVEYOR

Glenn S. Baughman

OREGON
JULY 14, 1961
GLENN S. BAUGHMAN
536

LEGEND

- ○ —— Found point (as noted)
- ● —— Set 1/2" iron rod
- ◎ —— Found N.E. cor. DLC No. 47 per C.S. 55/126

36403

C. S. File No. C.S. 58/126