FILED

RECEIVED

JUL 22 1976

COUNTY SURVEYOR
DOUGLAS COUNTY, ORE.

PLAT of LAND SURVEY in the

NW 1/4, NE 1/4, Sec. 5, T. 33S., R. 6W., W.M., Dgls. Cty., Ore.

Survey of: Lots 4-5-6, Blk. 13, City of Glendale.

SURVEY FOR: Earl R. Craig, owner
7th and Willis
Glendale, Ore. 97442

SURVEY BY: Ronald A. Brandt,
P.O. Box 427 P.E. 6803
Glendale, Ore. 97442

COUNTY SURVEYORS FILE DATA
DO NOT REMOVE FROM OFFICE

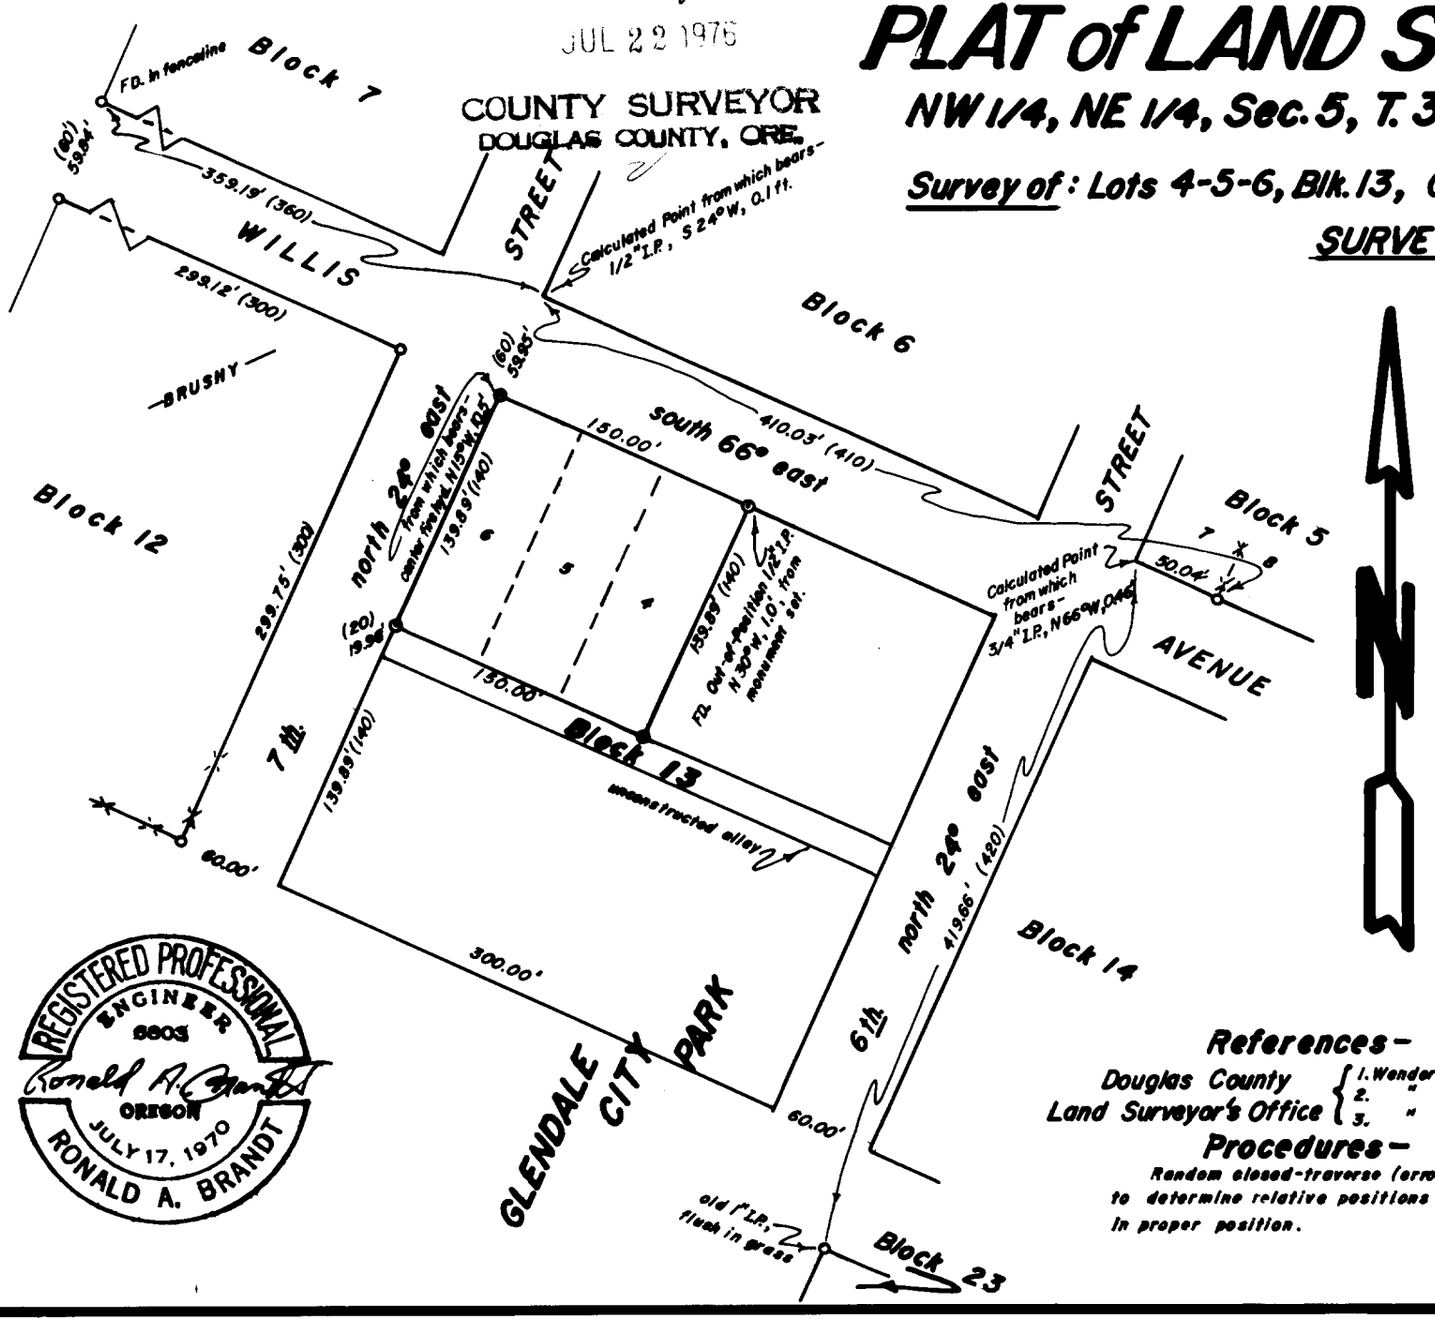

N

DATE: July 9-15, 1976

SCALE: 1 in. = 100 ft.

DATUM

MONUMENTS:

found — ○ 1/2" I.P. unless otherwise noted.

set — — ⊕ 3/4" x 36" I. Rod, set 2" to 4" high.

FENCELINE: —><—><—

PARENTHESIS ( ): MEANS OF RECORD.

References –

Douglas County Land Surveyor's Office
1. I. Wenderoth for Nelson, Sept. 1956, Blk. 25.
2. " " Davidson, " ", C.S. No. 46/174.
3. " "City of Glendale, Nov. 1963, Map file M 22-50

} Basis-of-Bearing.

Procedures –

Random closed-traverse (error 1/10,715) using a 30 sec. BURLEY TRANSIT and 300' steel tape to determine relative positions of FOUND monuments and then identifying those in proper position.

REGISTERED PROFESSIONAL ENGINEER
6803
Ronald A. Brandt
OREGON
JULY 17, 1970
RONALD A. BRANDT

C. S. File No. 58/111