


	BEARING	DISTANCE	LATITUDE	DEPARTURE	SUM LATS	SUM DEPS
N	90° 00' 00" E	34.500	.000	34.500	.000	34.500
N	35° 41' 00" E	235.650	191.407	137.456	191.407	171.956
N	74° 59' 00" E	116.050	30.069	112.087	221.476	284.043
N	41° 53' 00" E	90.060	67.050	60.125	288.526	344.168
N	68° 09' 00" E	109.560	40.776	101.689	329.302	445.858
N	40° 52' 00" E	145.700	110.183	95.332	439.485	541.189
N	76° 44' 00" E	158.670	36.412	154.436	475.898	695.625
N	46° 25' 00" E	112.550	77.593	81.528	553.490	777.153
N	63° 21' 00" E	138.230	62.002	123.545	615.492	900.698
N	34° 39' 00" E	87.620	72.080	49.817	687.572	950.515
N	58° 46' 00" E	80.100	41.534	68.491	729.106	1019.006
N	22° 13' 00" E	104.230	96.492	39.410	825.598	1058.416
N	49° 04' 00" W	378.810	248.189	-286.181	1073.787	772.236
S	42° 22' 30" W	102.000	-75.352	-68.746	998.434	703.490
S	40° 51' 30" W	245.000	-185.301	-160.277	813.133	543.213
S	38° 14' 30" W	325.000	-255.257	-201.168	557.876	342.044
S	38° 00' 00" W	60.000	-47.281	-36.940	510.596	305.105
S	30° 47' 00" W	221.330	-190.147	-113.275	320.449	191.830
S	30° 04' 00" W	191.720	-165.923	-96.053	154.526	95.776
S	36° 20' 00" W	183.970	-148.203	-108.999	6.323	-13.222
S	76° 00' 00" E	31.740	-7.679	30.797	-1.356	17.575

"A" ?

Area = 308232.564 sq. ft. or 7.076046 acres. -

-Error Inversion

N	85° 35' 21" W	17.627	1.356	-17.575	-.000	.000
---	---------------	--------	-------	---------	-------	------

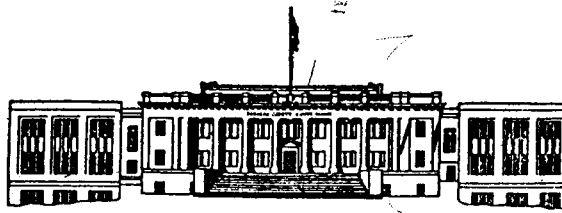

COUNTY OF DOUGLAS
OFFICE OF THE SURVEYOR
ROSEBURG, OREGON 97470

February 27, 1975

26 SKY VALLEY RANCHES
BUENA VISTA, CO
81211

Donald Martin
P. O. Box 2
Myrtle Creek, OR

Dear Mr. Martin:

This is a letter of inquiry about the Minor Land Partition for Oregon Acreages, In the NW 1/4 of Section 1, T. 29 S., R. 5 W., done by you in January, 1973, revised in June and July of 1973.

Several months ago, you picked up the mylar to make the necessary corrections for the lot closures. May we have information from you as to when this will be returned to our office?

Sincerely,

Virginia A. Yates

Virginia A. Yates
Office Supervisor

4-10-75 Martin in again. No solution - will check on it. di

5-19-75 WRITE A LETTER TO MARTIN IN COLO. ASKING FOR MYLAR. WILL FILE & PROCESS AS IS.
(REVIEWED.)

(SEE FOLDER FOR REMAINING INFO.)

	BEARING	DISTANCE	LATITUDE	DEPARTURE	SUM LATS	SUM DEPS
N	42° 22' 30" E	130.000	96.037	87.617	96.037	87.617
N	43° 07' 30" E	275.000	200.713	187.988	296.750	275.605
N	41° 27' 30" E	250.000	187.359	165.519	484.109	441.124
N	27° 33' 30" E	369.370	327.401	170.890	811.571	612.014
N	40° 55' 00" E	202.670	153.150	132.741	964.721	744.755
N	29° 52' 00" E	196.360	170.781	97.784	1135.002	842.539
N	87° 49' 00" E	234.230	8.923	234.060	1143.925	1076.599
S	33° 53' 00" E	99.700	-82.768	55.583	1061.157	1132.182
S	43° 52' 00" W	115.600	-83.342	-80.109	977.815	1052.073
S	20° 48' 00" W	103.840	-97.072	-36.874	880.742	1015.199
S	82° 50' 00" W	142.150	-17.734	-141.039	863.008	874.159
S	38° 00' 00" W	127.320	-100.330	-78.386	762.679	795.773
S	70° 44' 00" W	94.350	-31.132	-89.066	731.546	706.707
S ²³	28° 05' 00" W	127.420	-112.418	-59.984	619.128	646.724
S	25° 22' 00" E	104.040	-94.009	44.572	525.119	691.295
S	58° 54' 00" W	126.640	-65.414	-108.438	459.706	582.858
S	31° 11' 00" W	84.360	-72.171	-43.680	387.534	539.178
S	09° 55' 00" E	71.960	-70.885	12.393	316.650	551.571
S	13° 06' 00" W	99.510	-96.920	-22.554	219.729	529.017
S	41° 33' 00" W	101.320	-75.826	-67.203	143.904	461.814
S	19° 26' 00" W	136.640	-128.856	-45.461	15.048	416.352
S	05° 03' 00" E	93.770	-93.406	8.254	-78.358	424.606
S	17° 17' 00" W	119.810	-114.400	-35.595	-192.758	389.011
S	73° 48' 00" W	117.530	-32.790	-112.863	-225.548	276.148
Area =		350721.647 sq. ft. or	8.051461 acres.			
-Error Inversion						
N	50° 45' 33" W	356.552	225.548	-276.148	-.000	.000

B OK