SURVEY TO DIVIDE TRACT 12 LOCATED IN SEC. 6 & 7, T29S, R5W, WM

FOR L.A. SUITER JULY, 1976

BY HAROLD BALL — CE — ROSEBURG

REGISTERED PROFESSIONAL ENGINEER 6025 Harold L. Ball OREGON SEPT. 8, 1967 HAROLD L. BALL

COUNTY SURVEYORS FILE DATA
DO NOT REMOVE FROM OFFICE

FILED
RECEIVED MMC
JUL 30 1976
COUNTY SURVEYOR
DOUGLAS COUNTY, ORE.

C.S. 58/114-3

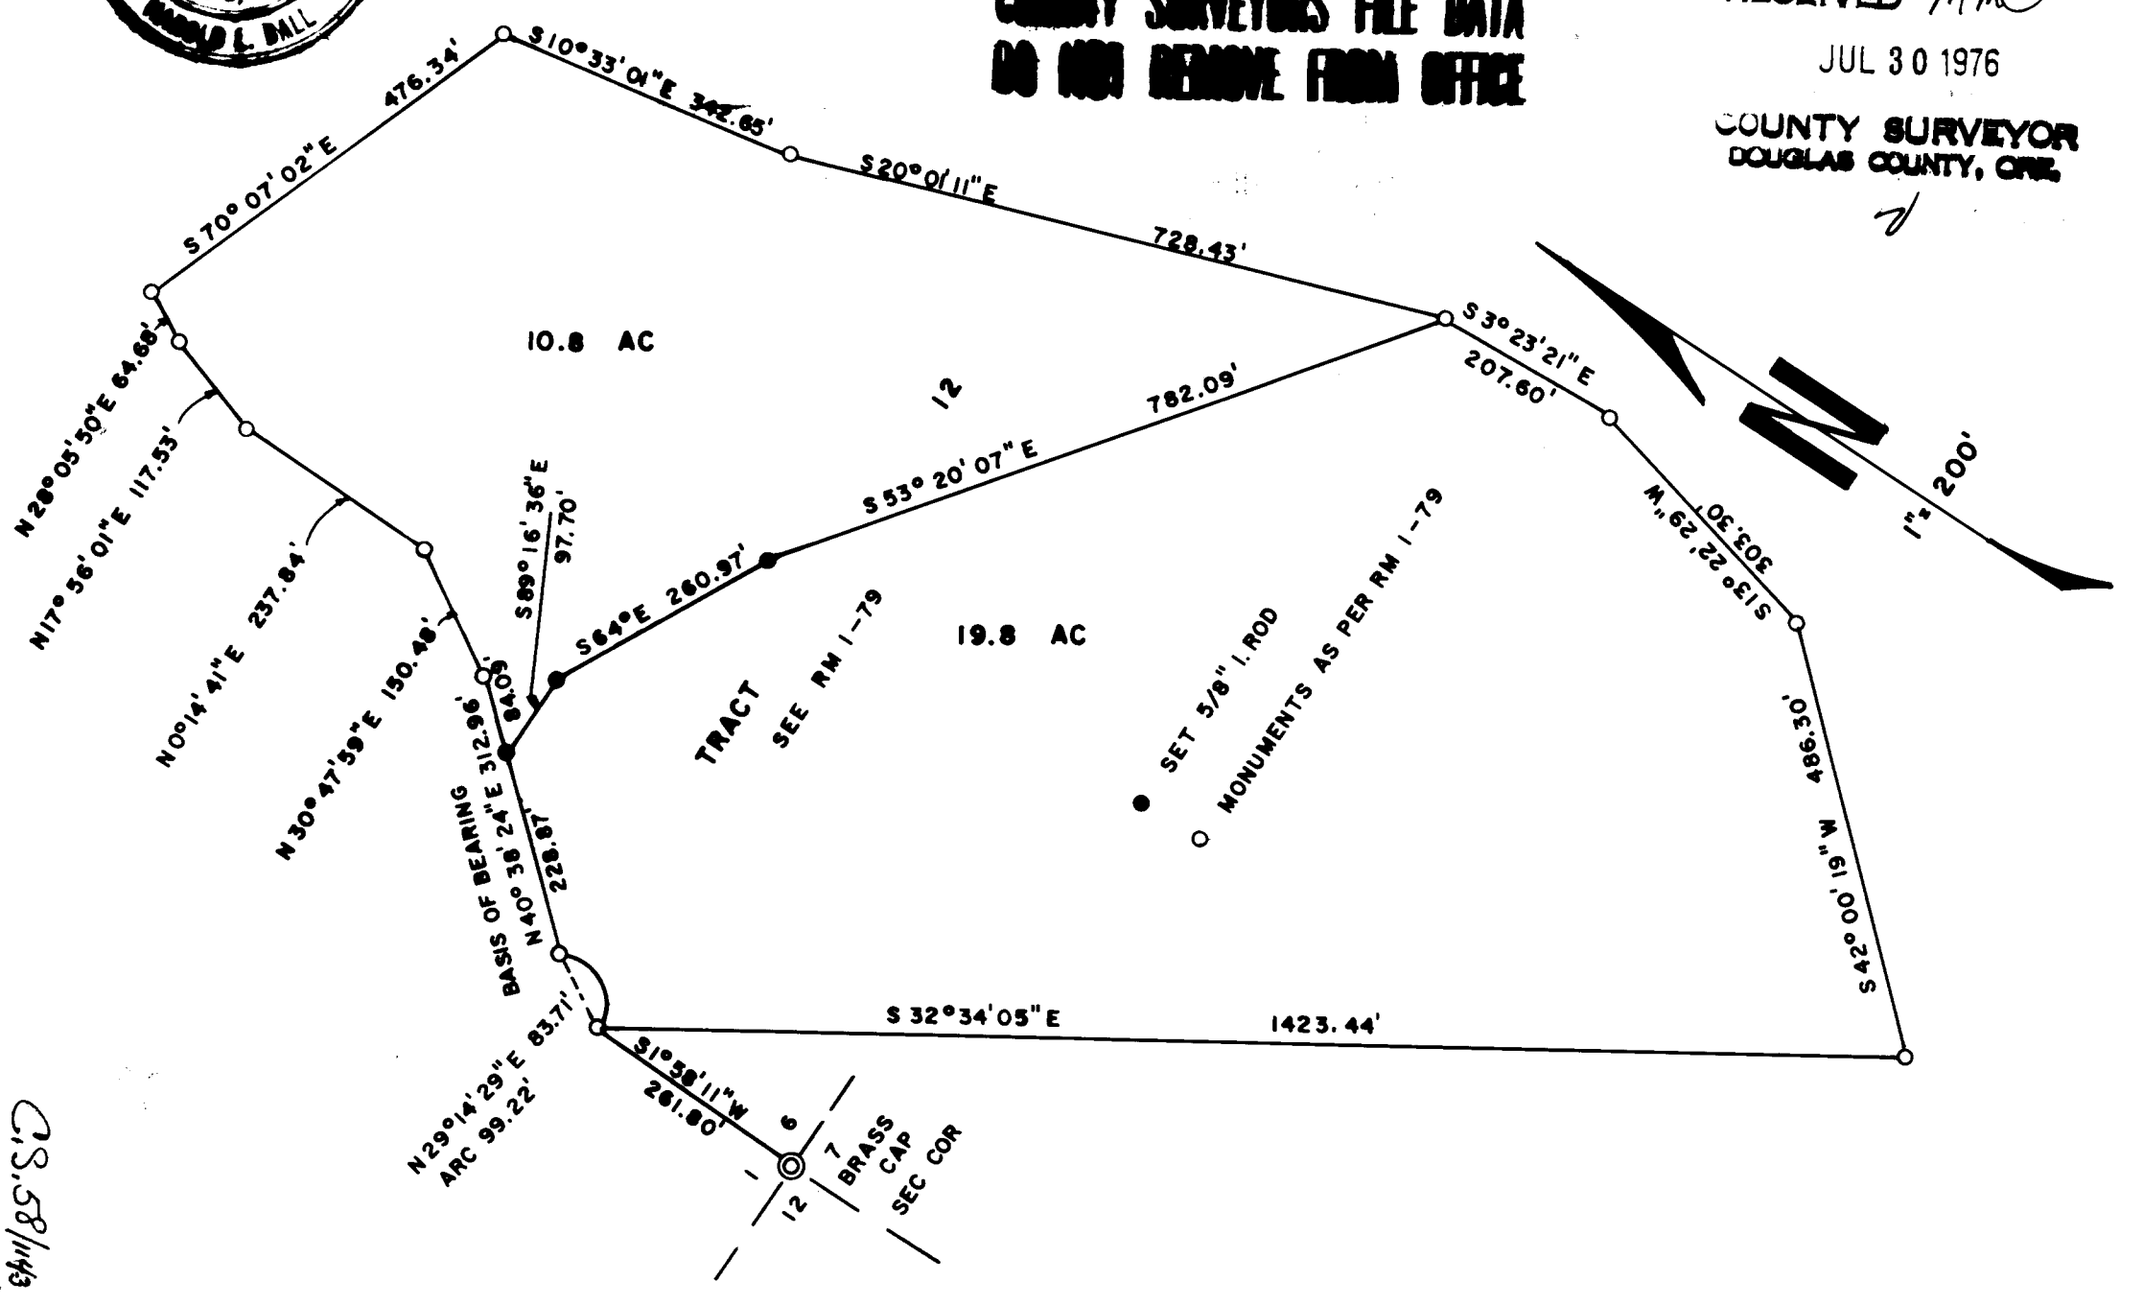

C.S. 58/114-3