SCALE: 1" = 100'

AUGUST 1980

LEGEND:

● — SET 5/8" x 30" IRON ROD

o — FD. MONUMENT AS NOTED

NARRATIVE: SURVEY TO SET MONUMENTS AS SHOWN ON THE SOUTH LINE OF THAT SURVEY FILE M26-62.

FILED
RECEIVED
SEP 15 1980
COUNTY SURVEYOR
DOUGLAS COUNTY, ORE.

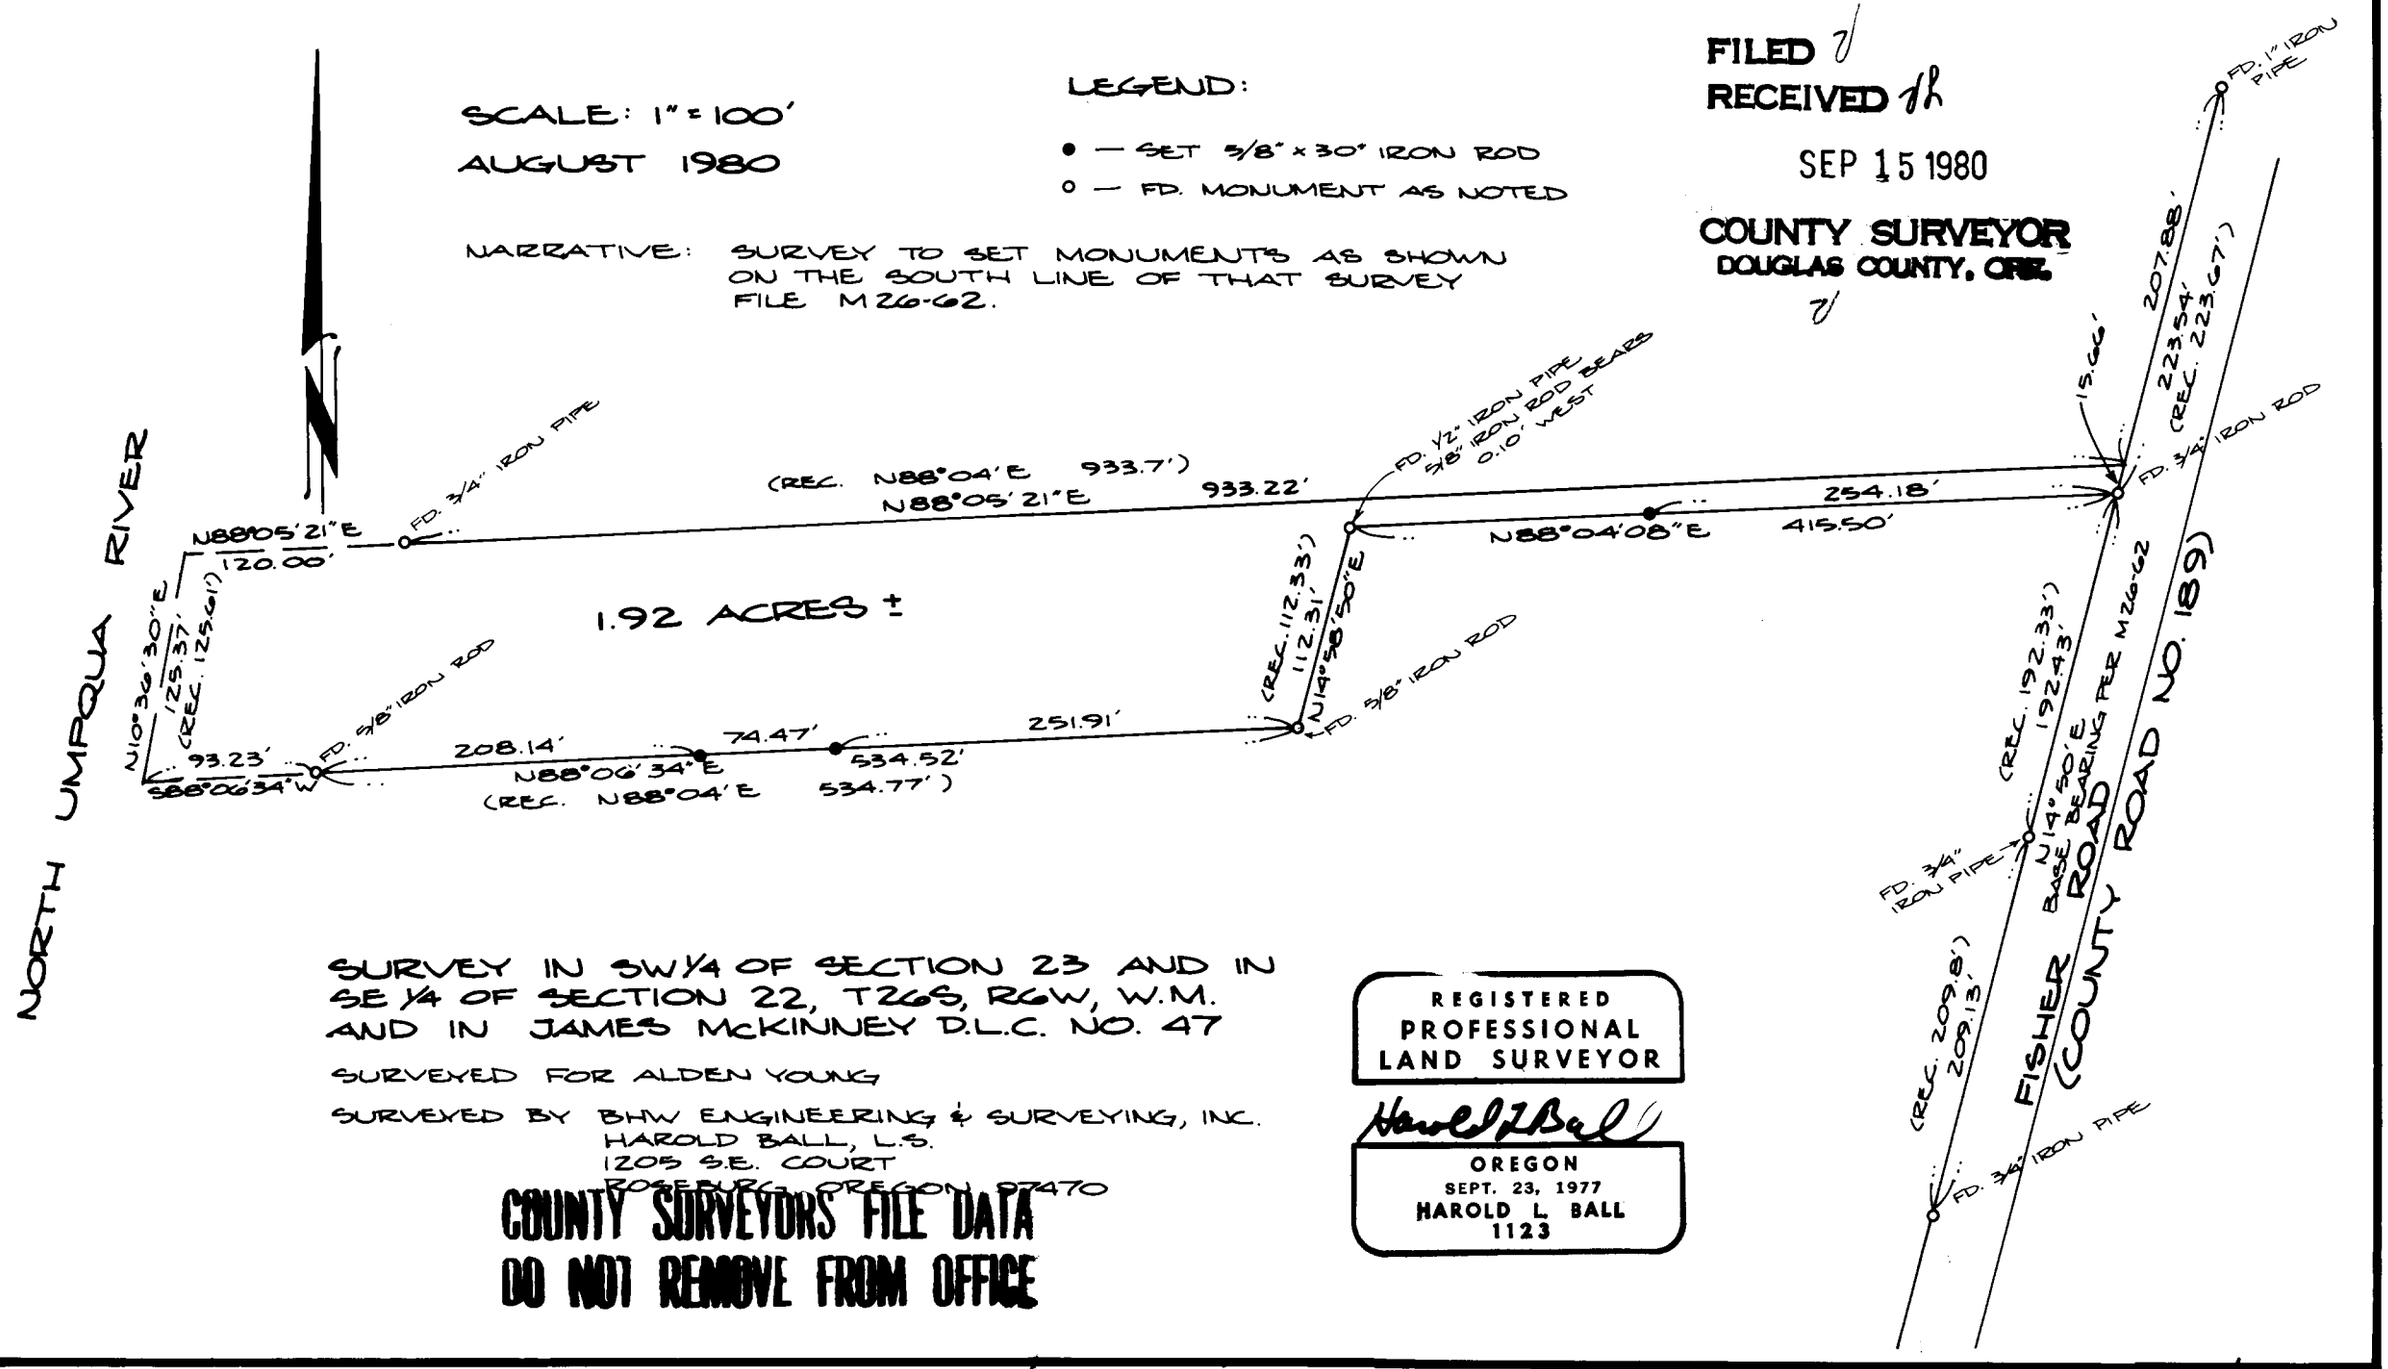

SURVEY IN SW¼ OF SECTION 23 AND IN SE¼ OF SECTION 22, T26S, R6W, W.M. AND IN JAMES McKINNEY D.L.C. NO. 47

SURVEYED FOR ALDEN YOUNG

SURVEYED BY BHW ENGINEERING & SURVEYING, INC.
HAROLD BALL, L.S.
1205 S.E. COURT
ROSEBURG, OREGON 97470

REGISTERED PROFESSIONAL LAND SURVEYOR
Harold L Ball
OREGON
SEPT. 23, 1977
HAROLD L. BALL
1123

COUNTY SURVEYORS FILE DATA
DO NOT REMOVE FROM OFFICE