FILED ✓
RECEIVED WRS
AUG 30 1976
COUNTY SURVEYOR
DOUGLAS COUNTY, ORE.

C.S. File No. 58/118-1

FIELD SURVEY OF DEED DESCRIPTION

SECTION 22 T. 29S. R. 5W. W.M. DOUGLAS COUNTY, OREGON

FOR: M.E. AGEE
BRUCE E. AGEE
JAMES A. AGEE
DAVID P. AGEE

UMPQUA RESEARCH CO. ✓
MYRTLE CREEK, OREGON
AUG 1976

COUNTY SURVEYOR'S FILE DATA
DO NOT REMOVE FROM OFFICE

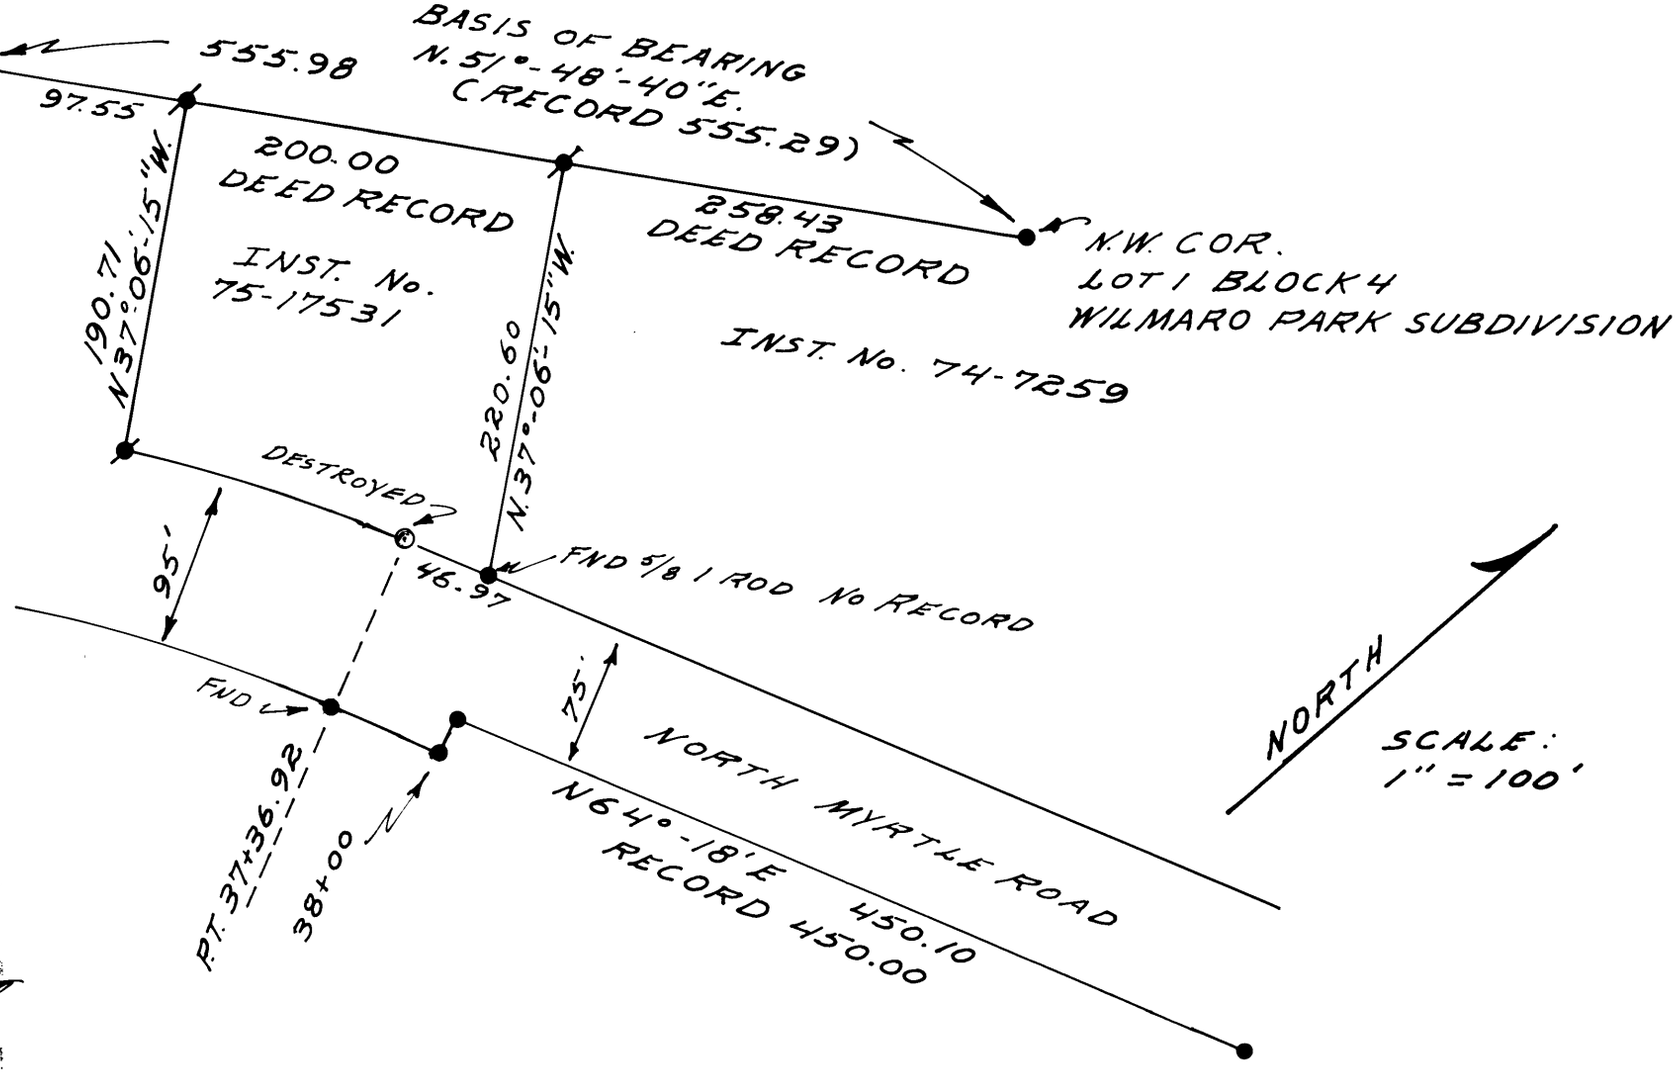

LEGEND:

✓ SET 5/8" I ROD

● FOUND 5/8" I. ROD

CURVE DATA:

R - 858.51
Δ - 10°-20'-51"
L - 155.05

CHORD:
LENGTH 154.83
BEARING N. 59°-06'-33" E

C.S. File No. 58/118-1