FILED
RECEIVED
OCT 26 1976
COUNTY SURVEYOR
DOUGLAS COUNTY, ORE.

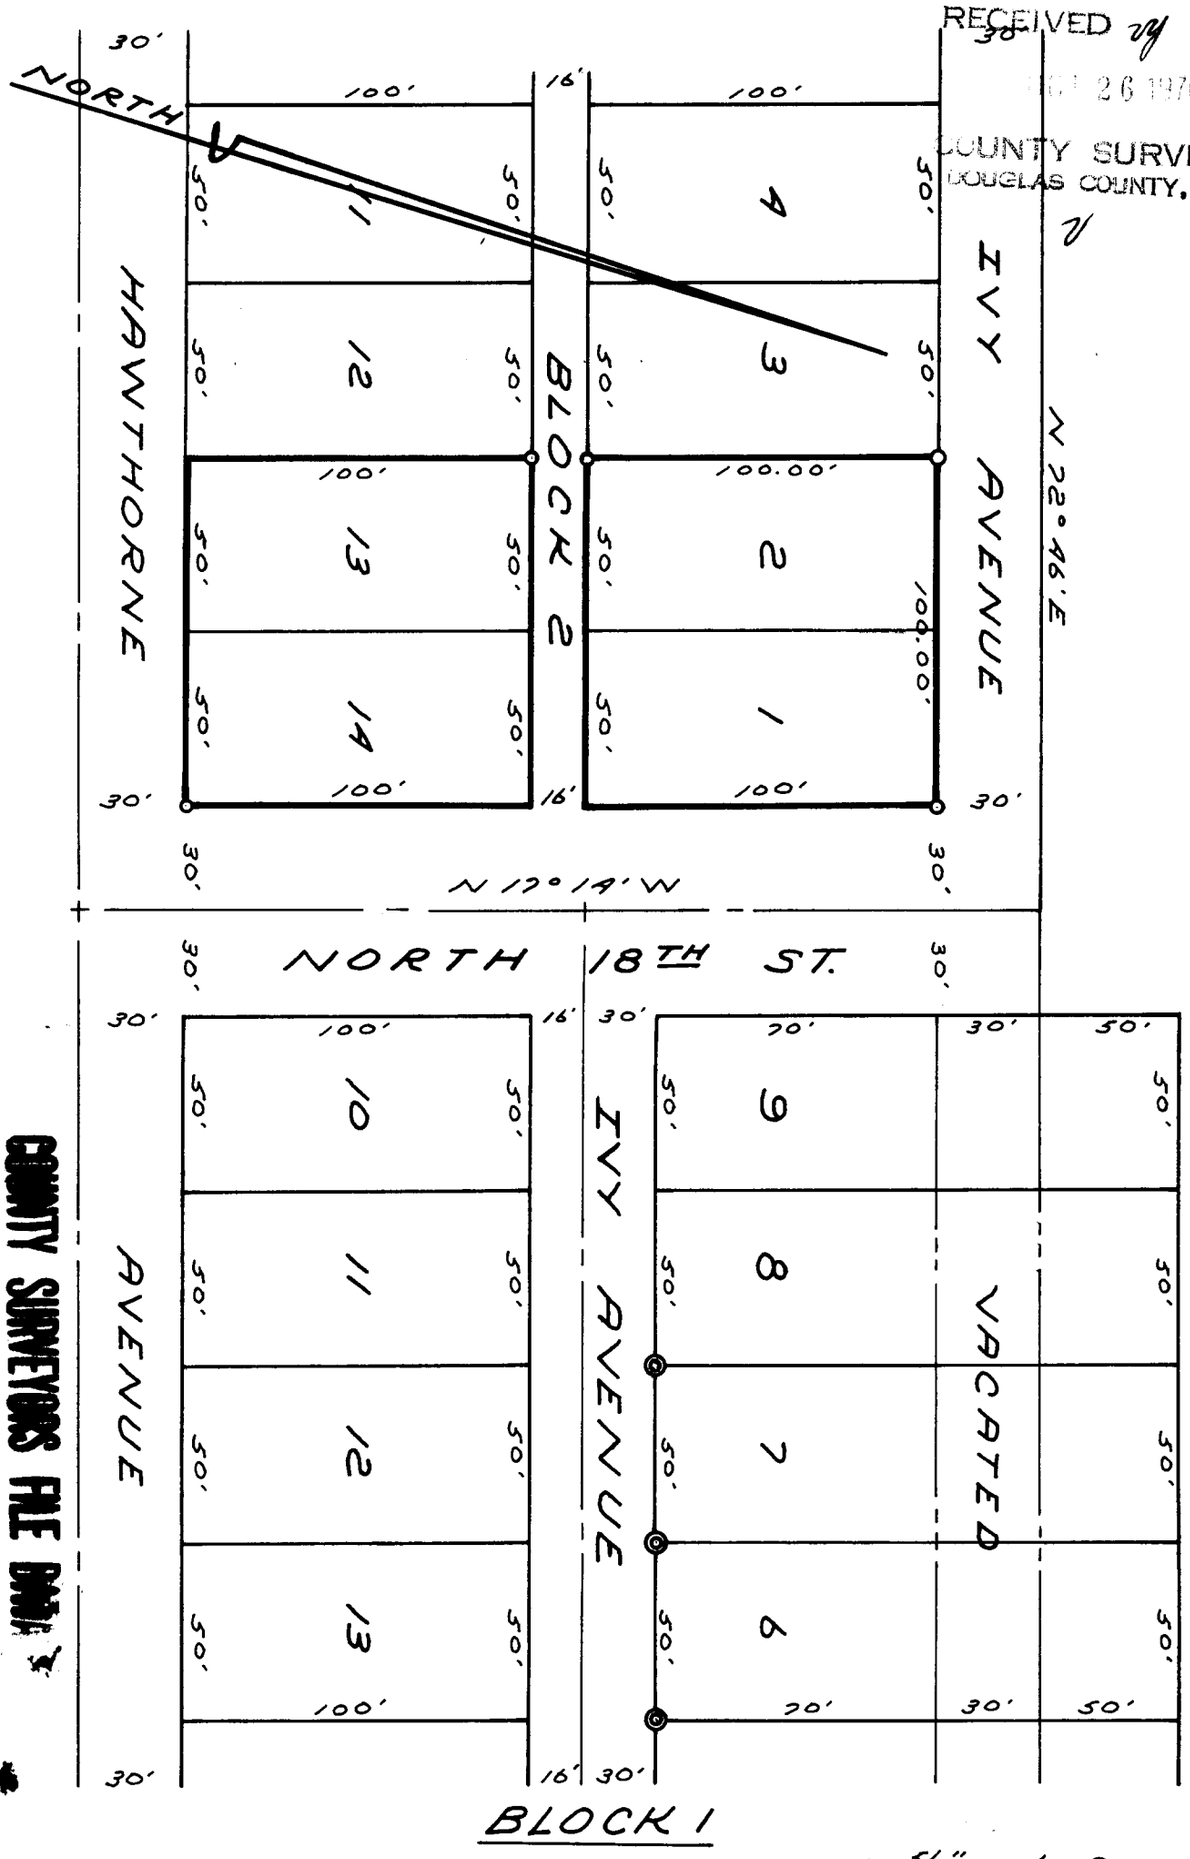

FND. 5/8" I.R.'S ◉
SET 5/8" I.R.'S ○

COUNTY SURVEYORS FILE DATA
DO NOT REMOVE FROM OFFICE

REGISTERED
PROFESSIONAL
LAND SURVEYOR
Richard J. Hintz
OREGON
MAY 13, 1960
RICHARD J. HINTZ
497

PROPERTY SURVEY
FOR
HEINZ KAUFMANN
LOTS 1, 2, 13 & 14, BLOCK 2
REEDSPORT ADDITION
SE SW, SECTION 34, T21S, R12W
OCTOBER 1976 SCALE 1" = 50'

C.S. 58/120-2