FILED
RECEIVED
AUG 29 1977
COUNTY SURVEYOR
LANE COUNTY, ORE.

COUNTY SURVEYORS FILE DATA
DO NOT REMOVE FROM OFFICE

REGISTERED PROFESSIONAL LAND SURVEYOR
OREGON
MAY 13, 1960
RICHARD J. HINTZ
497

PROPERTY SURVEY
FOR
HEINZ KAUFMANN
SOUTH 70' OF LOTS 15 & 16
BLOCK 3
RAINBOW ADDITION #2
NE 1/4 SE 1/4, SEC. 34, T21S, R12W
JULY 1977 SCALE 1" = 50'

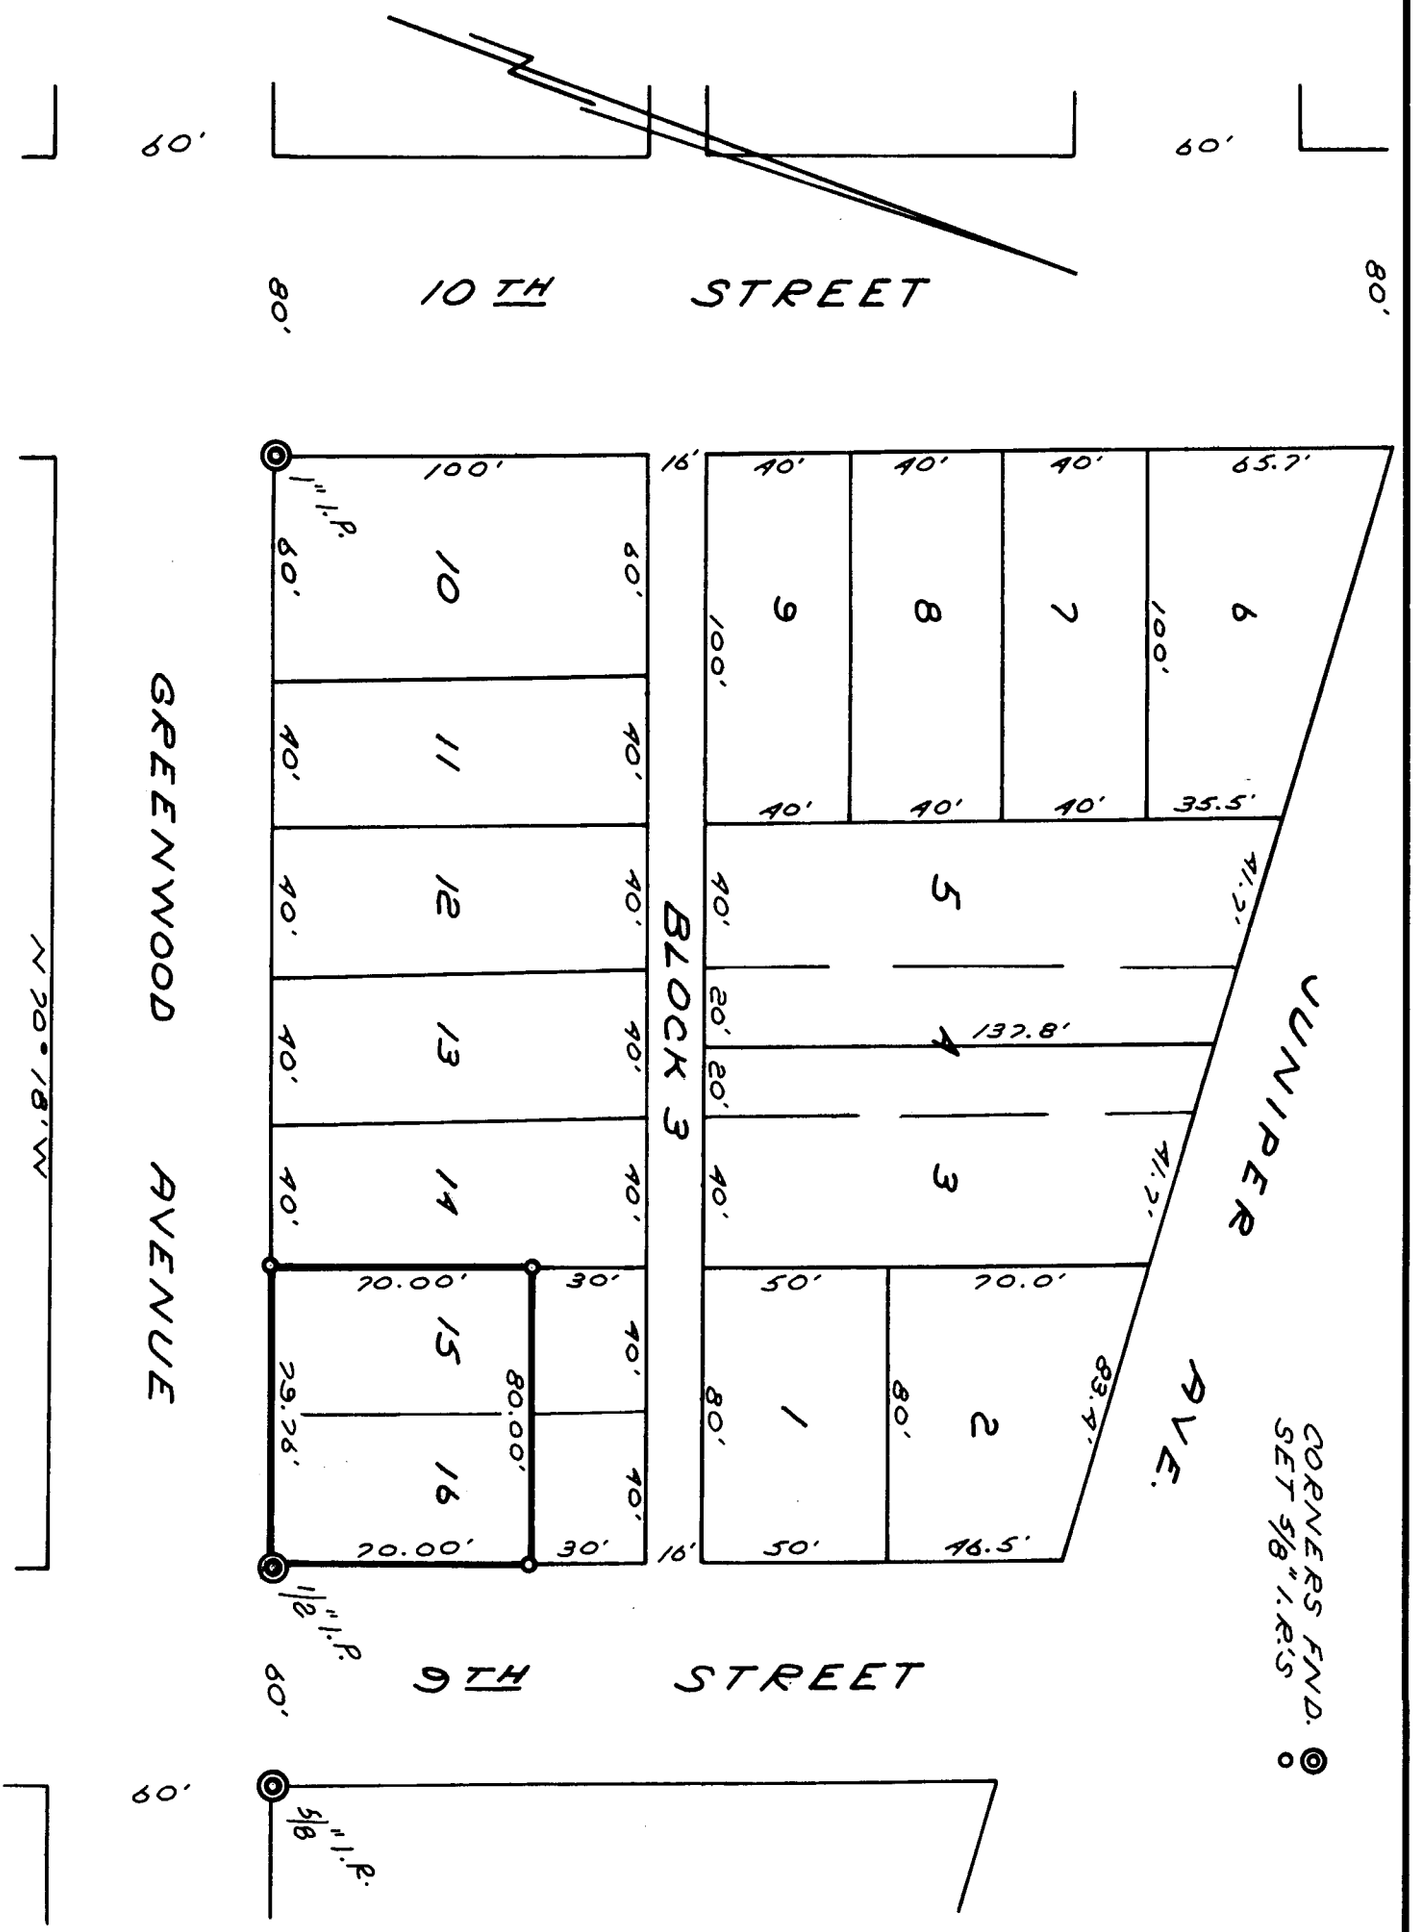

C. S. File No. 58/121-6