SURVEY TO SET PROPERTY CORNER

IN LOT 1, SOUTHWEST TERRACE - SECTION 30, T.27S. R.6W.W.M.

FOR: WILLIAM J. WELTY

BY: C & G ENG, INC.

NOVEMBER 1976 — SCALE: 1" = 100'

FILED ✓
RECEIVED ✓

DEC 30 1976

COUNTY SURVEYOR
DOUGLAS COUNTY, ORE.

COUNTY SURVEYORS FILE DATA
DO NOT REMOVE FROM OFFICE

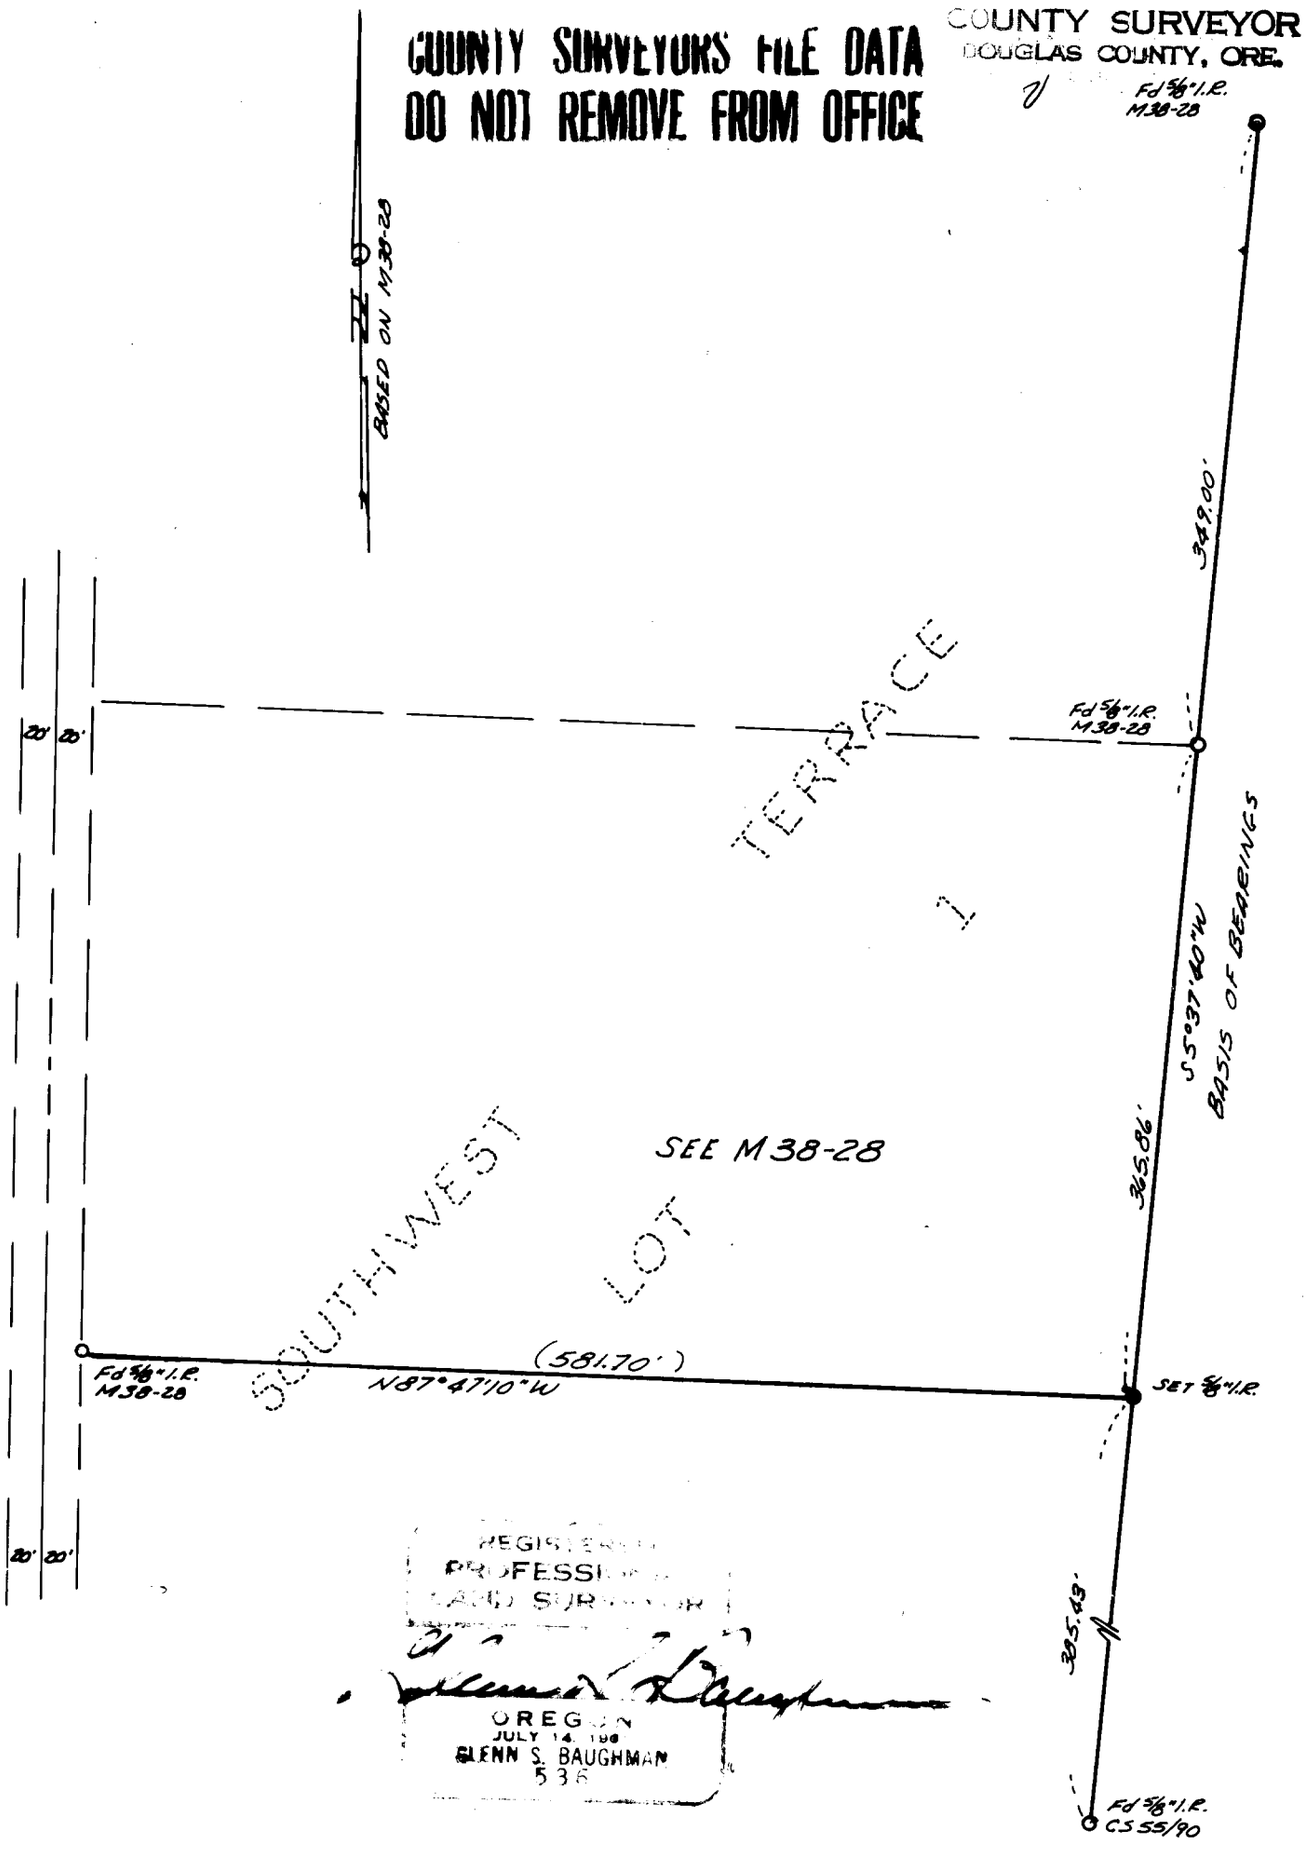

REGISTERED PROFESSIONAL LAND SURVEYOR
OREGON
JULY 14, 198
GLENN S. BAUGHMAN
536

C. S. File No. 58/122-3 6140.0140