SURVEY IN ~~LOT 3~~ LOT 1, BLOCK 4, "CANTERBURY ESTATES-PHASE 1"

SURVEY FOR HAROLD JOHNSON T.27S R.6W SECS. 15

SURVEY BY BHW ENG. & SURVEYING, INC.

FEB., 1977 SCALE: 1" = 50'

o — FD. 3/4" I. PIPE

• — SET 5/8" I. ROD

COUNTY SURVEYORS FILE DATA
DO NOT REMOVE FROM OFFICE

FILED ✓
RECEIVED ✓
MAR 17 1977
COUNTY SURVEYOR
DOUGLAS COUNTY, ORE.
MC

BEARINGS BASED ON "CANTERBURY ESTATES- PHASE I" AS RECORDED IN VOL. 15, PAGE 37 IN THE PLAT RECORDS OF DOUGLAS COUNTY, OREGON.

REGISTERED PROFESSIONAL LAND SURVEYOR

Romanso E. Ware

OREGON
NOV. 16, 1973
ROMANSO E. WARE
1005

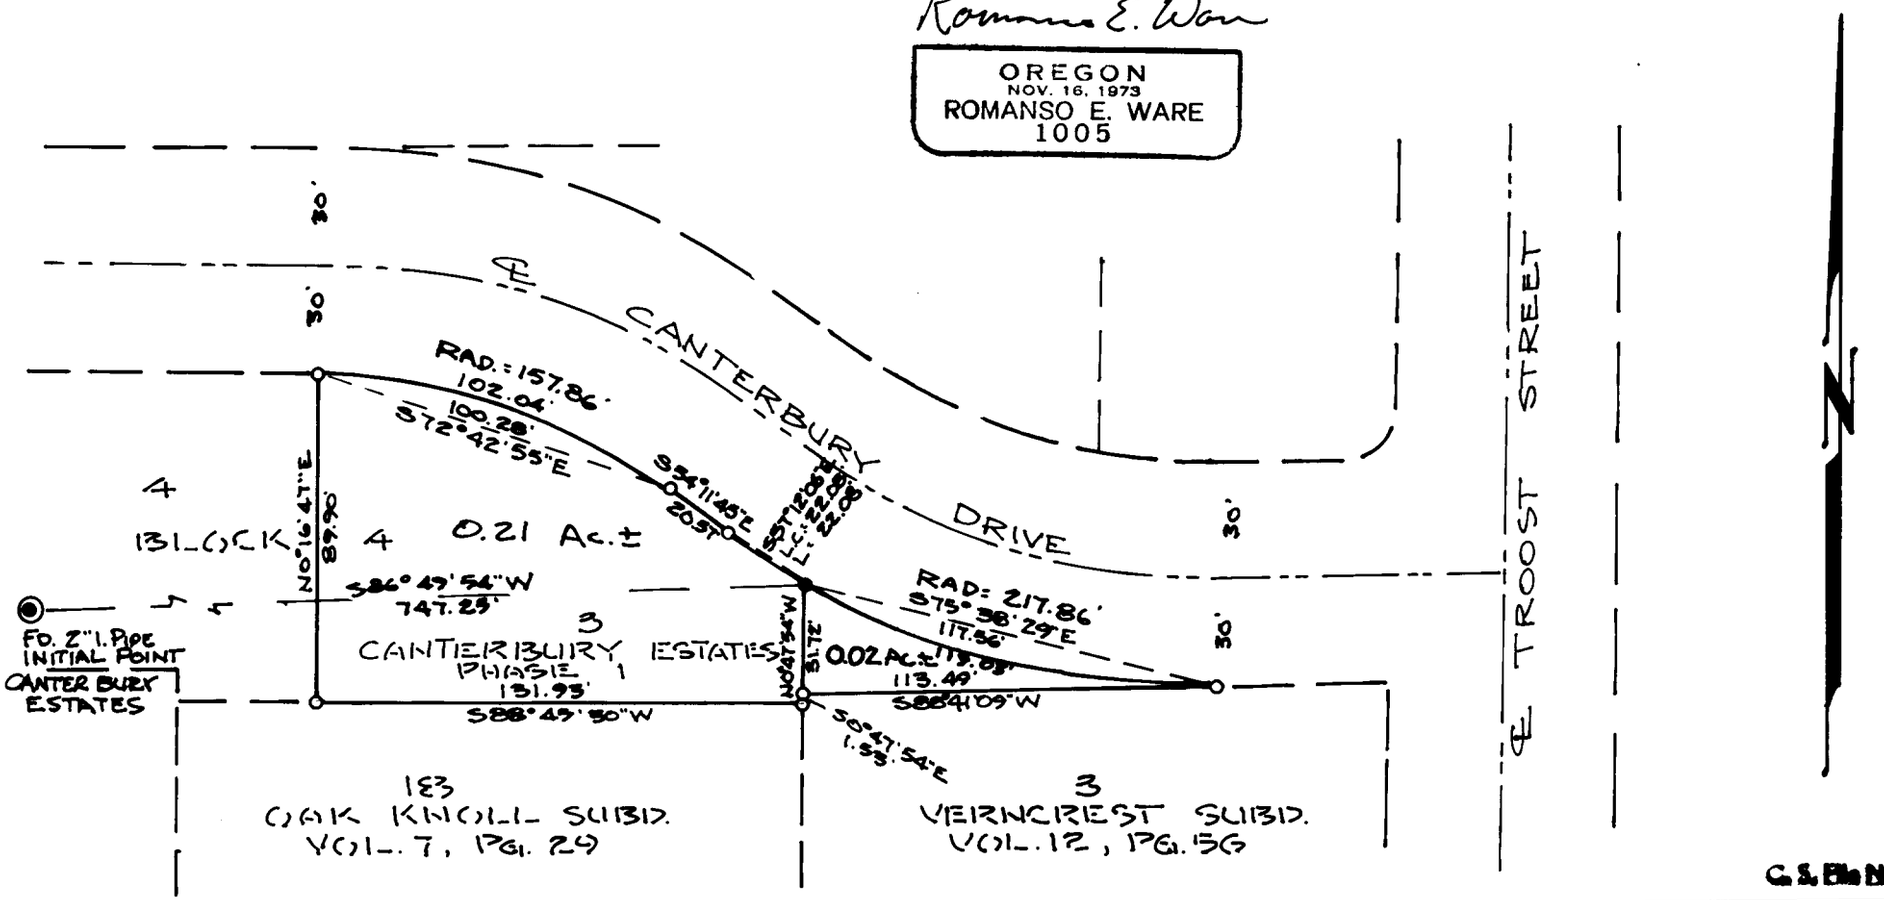

C.S. File No. 58/133-5