M84-4

UMPQUA SURVEYING COMPANY

P. O. Box 791
Myrtle Creek, Oregon 97457

626 N.E. Division Street
Telephone (503) 863-5201

FILED
RECEIVED

JUN 18 1980

COUNTY SURVEYOR
DOUGLAS COUNTY, ORE.

SURVEY NARRATIVE

June 1980

FOR: U. S. FOREST SERVICE

LOCATION: SOUTH & EAST LINES OF SECTION 36, TOWNSHIP 31 SOUTH, RANGE 3 WEST, WILLAMETTE MERIDIAN.

PURPOSE: TO PLACE LINE MONUMENTS ON EAST AND SOUTH LINES OF SECTION 36. TO REPLACE EAST ¼ CORNER OF SECTION 36 BY PROPORTIONATE MEASUREMENT.

EVIDENCE: FOUND CORNERS AND ACCESSORIES AS SHOWN ON ACCOMPANYING SURVEY PLAT. ALSO FOUND THE SOUTH ¼ CORNER TO SECTION 36, THE NORTH ¼ CORNER OF SECTION 1, TOWNSHIP 32 SOUTH, RANGE 3 WEST, AND THE CORNER COMMON TO SECTIONS 35 AND 36, TOWNSHIP 31 SOUTH, RANGE 3 WEST, AND 1 AND 2 TOWNSHIP 32 SOUTH, RANGE 2 WEST. THE CORNER DESCRIPTIONS AND ACCESSORIES OF THESE THREE CORNERS ARE IN AGREEMENT WITH THE SURVEY PER M83-53. THE SOUTH ¼ CORNER OF 36 WAS RENEWED. SEE THE COPY OF U.S.F.S. FORM R6-7100-57 FILED WITH THE DOUGLAS COUNTY SURVEYORS OFFICE. A LINE TREE WAS ALSO FOUND AS SHOWN IN THE DIAGRAM BELOW.

CONCLUSION: I ACCEPTED ALL MONUMENTS AND THE LINE TREE AS SHOWN BELOW AND ON THE ACCOMPANYING PLAT. THE ¼ CORNER WAS PROPORTIONED USING DISTANCES PER GLO PLAT OF JUNE 18, 1909.

EQUIPMENT: LEITZ T6OD THEODOLITE
MAC AND BEEDLE EDM.

-24A

U. S. File No. 58/143

M 84-4

Sec. 36, T31S, R3W

POSTING: LINE MONUMENTS ARE 6' ORANGE FIBERGLAS POSTS WITH U.S.F.S. SIGNS 52-2 ATTACHED.

DIAGRAM OF POSTED LINE: 1" = 1000 ft.

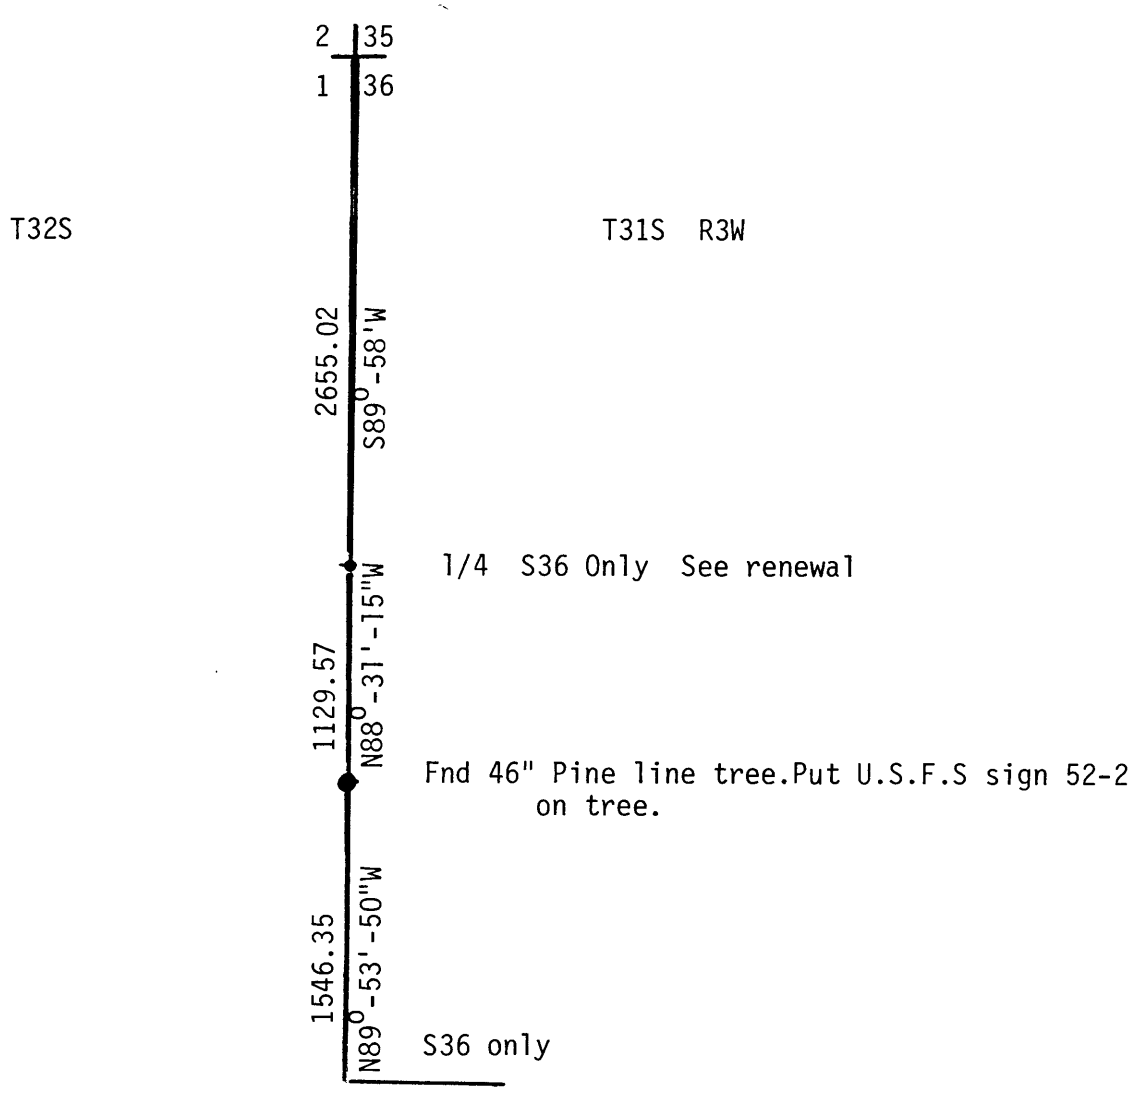

REGISTERED
OREGON
LAND SURVEYOR

JULY 12, 1968
WILLIAM J. RUPPERT
866

G.S. File No. 58/143-24B